

089 09 08  
33 07 46 N

MISSISSIPPI  
BOARD OF WATER COMMISSIONERS  
416 North State Street  
Jackson, Mississippi 39201

COPIED

Winston  
D20  
3-5-70

WATER WELL DRILLERS LOG

3/5 1970 J. N. McDonald Winston  
date well completed firm name county well located

LANDOWNER: Curt S. Rash  
Louisville, Miss.  
(mailing address)

description of formations encountered	from	to
Red Clay	0	20
Gray Clay	20	80
White Silt	80	120
Gray Sand/Clay	120	126
Sandy Sand	126	152

WELL LOCATION:  
sec 27 T 15 N R 11 E  
7 miles NW of Louisville  
(distance) (direction) (nearest town)

WELL PURPOSE:  
(home, irrigation, municipal, industrial)

- WELL COMPLETION DATA:
- (1) diameter (inches) 2 1/2"
  - (2) total depth (feet) 152'
  - (3) static water level (feet) 126' below top of ground.
  - (4) casing 2 1/2" (material) 147' (depth)  
(size) if telescope see back.
  - (5) screen 5' (length) (depth to top)  
1 1/4" (size) (material)
  - (6) pump 1/2 (HP) 5 gal (yield gpm)  
electric (type power)
  - (7) electric log No (yes or no)
  - (organization running log)
  - (8) how well bottom plugged

COPIED


APR 22 1970

MISS. BD. OF  
WATER COMMISSIONERS

DRILLERS REMARKS:

If well telescopes please sketch and show depths.

GROUND LEVEL

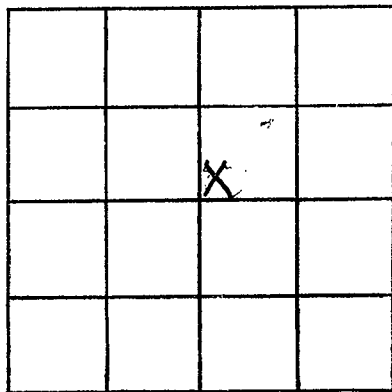

SECTION 27

Please indicate well location X.

ADDITIONAL INFORMATION

If more than one screen,  
show locations of each on sketch.