

WINSTON
D-23
7-6-71

MISSISSIPPI
BOARD OF WATER COMMISSIONERS
416 North State Street
Jackson, Mississippi 39201

CODED

WATER WELL DRILLERS LOG

7-6 1971 Thomas & Son @ Winston
date well completed firm name county well located

LANDOWNER: W. K. Roney
ACKERMAN, Miss
(mailing address)

description of formations encountered	from	to
<u>DRY SAND</u>	<u>0</u>	<u>40</u>
<u>Course SAND</u>	<u>40</u>	<u>54</u>

WELL LOCATION:
sec. 18 T 15 N R 11 E
7 miles NW of Lewisville
(distance) (direction) (nearest town)

WELL PURPOSE:
(home, irrigation, municipal, industrial)


- WELL COMPLETION DATA:
- (1) diameter (inches) 2
 - (2) total depth (feet) 54
 - (3) static water level (feet) 40 below
top of ground.
 - (4) casing PVC, 49,
(material) (depth)
2
(size) if telescope see back.
 - (5) screen 5, 49
(length) (depth to top)
2", 83/ot, S-S.
(size) (material)
 - (6) pump 3/4, 7
(HP) (yield gpm)
Elec.
(type power)
 - (7) electric log no
(yes or no)

(organization running log)
(8) how well bottom plugged Point

DRILLERS REMARKS:
AUG 31 1971
MISS. BD. OF
WATER COMMISSIONERS

If well telescopes please sketch and show depths.

GROUND LEVEL

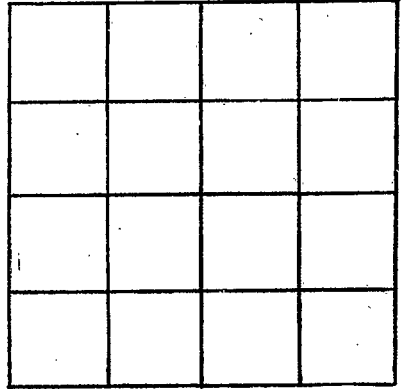

SECTION _____

Please indicate well location X.

ADDITIONAL INFORMATION

If more than one screen, show locations of each on sketch.