

WINSTON
D 26
6-25-73

MISSISSIPPI
BOARD OF WATER COMMISSIONERS
416 North State Street
Jackson, Mississippi 39201

CODED

WATER WELL DRILLERS LOG

6-25 1973 JH McDonald Winston
date well completed firm name county well located

LANDOWNER: H M Kennedy
me cal. Miss

description of formations encountered	from	to
<u>red clay</u>	<u>0</u>	<u>30</u>
<u>pipe clay sand</u>	<u>30</u>	<u>90</u>
<u>white sand</u>	<u>90</u>	<u>105</u>

(mailing address)

WELL LOCATION:
sec. 18 T 15 N R 11 E
S W
10 miles 9W of Louisville
(distance) (direction) (nearest town)

WELL PURPOSE: Home
(home, irrigation, municipal, industrial)

- WELL COMPLETION DATA:
- (1) diameter (inches) 2
 - (2) total depth (feet) 104
 - (3) static water level (feet) 90 below above top of ground.
 - (4) casing PVC 100
(material) (depth)
2"
(size) if telescope see back.
 - (5) screen 5' 164 99
(length) (depth to top)
2" 8 slot PVC
(size) (material)
 - (6) pump 1
(HP) (yield gpm)
electric
(type power)
 - (7) electric log no
(yes or no)
 - (8) how well bottom plugged _____
(organization running log)


CODED

DRILLERS REMARKS:

JUL 26 1973

If well telescopes please sketch and show depths.

GROUND LEVEL

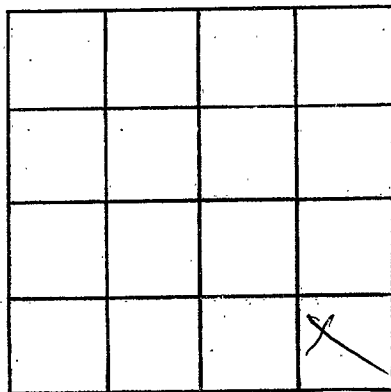

SECTION 2

Please indicate well location X.

ADDITIONAL INFORMATION

If more than one screen, show locations of each on sketch.