

WINSTON
 D 27
 9-21-73

MISSISSIPPI
 BOARD OF WATER COMMISSIONERS
 416 North State Street
 Jackson, Mississippi 39201

WATER WELL DRILLERS LOG

CODED

9-21-1973 date well completed
 H. H. McDonald firm name
 Winston county well located

LANDOWNER: Wesley D. Perry
Lancaster, Miss

description of formations encountered	from	to
red clay	0	25
pipe clay sand	25	70
white sand	70	90

(mailing address)

WELL LOCATION:

sec. 20 T. 15 N. R. 11 E. S. W
 (distance) miles of (direction) (nearest town)

WELL PURPOSE: Home
 (home, irrigation, municipal, industrial)

WELL COMPLETION DATA:

- (1) diameter (inches) 2"
 - (2) total depth (feet) 90
 - (3) static water level (feet) 60 below top of ground.
 - (4) casing PVC (material), 85 (depth)
2" (size) if telescope see back.
 - (5) screen 5' (length), 90-85 (depth to top)
1/2" (size), PVC Plastic (material)
 - (6) pump 1 (HP), 6 (yield gpm)
electric (type power)
 - (7) electric log no (yes or no)
- (organization running log)
- (8) how well bottom plugged


CODED

DRILLERS REMARKS:

DEC 20 1973

If well telescopes please sketch and show depths.

GROUND LEVEL

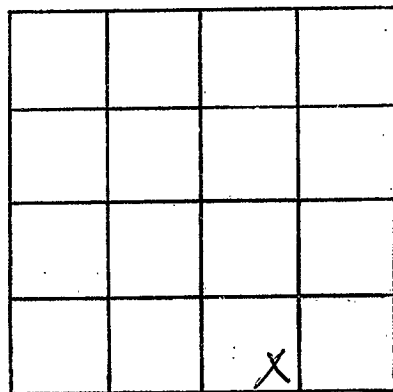

SECTION 20

Please indicate well location X.

ADDITIONAL INFORMATION

If more than one screen, show locations of each on sketch.