

WINSTON  
D28  
1-21-74

MISSISSIPPI  
BOARD OF WATER COMMISSIONERS  
416 North State Street  
Jackson, Mississippi 39201

CODED

WATER WELL DRILLERS LOG

1-21 date well completed 1974 J. H. McDonald firm name Winston county well located

LANDOWNER: Wade Heath  
Louisville Miss  
(mailing address)

description of formations encountered	from	to
red clay	8	19
sand & clay	19	40
white sand	40	70

WELL LOCATION:  
sec. 30 T. 15 N. R. 11 E  
9 miles west of Louisville  
(distance) (direction) (nearest town)

WELL PURPOSE: Home  
(home, irrigation, municipal, industrial)

- WELL COMPLETION DATA:
- (1) diameter (inches) 2
  - (2) total depth (feet) 65
  - (3) static water level (feet) 35 below top of ground.
  - (4) casing PVC, 60 (material) (depth)  
2" (size) if telescope see back.
  - (5) screen 4' 9 slot 64-60 (length) (depth to top)  
1/2" stainless steel (size) (material)
  - (6) pump 1 (HP) 10 (yield gpm)  
electric (type power)
  - (7) electric log no (yes or no)
  - (8) how well bottom plugged

DRILLERS REMARKS:


CODED

RECEIVED  
APR - 2 - 1974

MISS. BD. OF WATER COMMISSIONERS

If well telescopes please sketch and show depths.

GROUND LEVEL

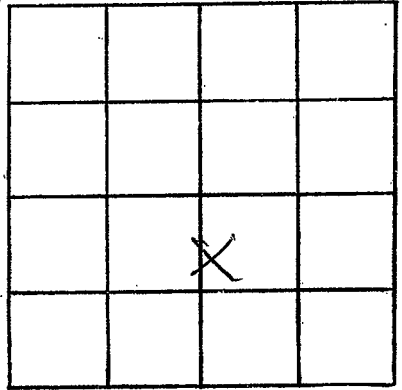

SECTION 30

Please indicate well location X.

ADDITIONAL INFORMATION

If more than one screen, show locations of each on sketch.