

WINSTON
 D29
 2-22-75

MISSISSIPPI
 BOARD OF WATER COMMISSIONERS
 416 North State Street
 Jackson, Mississippi 39201

WATER WELL DRILLERS LOG

00152

~~2-22~~ 2-22 1975 GH McDonald Winston
 date well completed firm name county well located

LANDOWNER: Ralph Dempsey
Louisville Miss.

description of formations encountered	from	to
<u>red clay</u>	<u>0</u>	<u>15</u>
<u>sand & clay</u>	<u>15</u>	<u>55</u>
<u>white sand</u>	<u>55</u>	<u>80</u>

(mailing address)

WELL LOCATION:
 sec. 29 T. 15 N. R. 11 E
 S W
0.5 miles west of Louisville
 (distance) (direction) (nearest town)

WELL PURPOSE: House
 (home, irrigation, municipal, industrial)

- WELL COMPLETION DATA:
- (1) diameter (inches) 2"
 - (2) total depth (feet) 76
 - (3) static water level (feet) 50 below above top of ground.
 - (4) casing PVC 72
 (material) (depth)
2" if telescope see back.
 (size)
 - (5) screen 4' 76 72
 (length) (depth to top)
1/4 Galat SS
 (size) (material)
 - (6) pump 1 8
 (HP) (yield gpm)
electric
 (type power)
 - (7) electric log no
 (yes or no)

(organization running log)


(8) how well bottom plugged

DRILLERS REMARKS:

RECEIVED
 MAR 17 1975

If well telescopes please sketch and show depths.

GROUND LEVEL

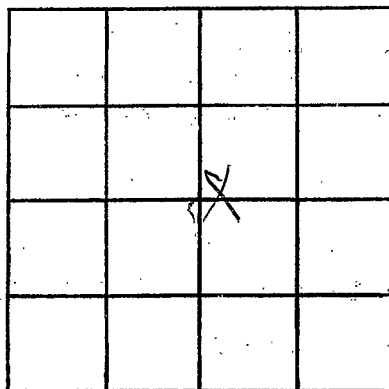

SECTION 29

Please indicate well location X.

ADDITIONAL INFORMATION

If more than one screen, show locations of each on sketch.