

MISSISSIPPI DEPARTMENT OF ENVIRONMENTAL QUALITY

Office of Land and Water Resources

P. O. Box 10631
Jackson, MS 39289-0631
WATER WELL DRILLERS LOG

159

COUNTY WELL LOCATED
Winston

WELL NUMBER
D-33

CODED

PERMIT NUMBER

DATE WELL COMPLETED
6/8/04

NAME OF DRILLING FIRM
MS Water Well Drilling Co

NAME & MAILING ADDRESS OF LANDOWNER
Barbron Wilson
140 Dempsey Rd
Louisville MS 39339

Latitude:
Longitude:

WELL LOCATION. SEC TOWNSHIP RANGE
28 15 S 11 E

DISTANCE DIRECTION NEAREST TOWN
5 Miles West of Louisville

OTHER LANDMARK

WELL PURPOSE (Home) Irrigation, Municipal, Industrial, Fish Pond, etc.

PUMP DATA

PUMP TYPE (Circle One):
Submersible, Turbine, Jet, Flowing Well,
Other (Describe)

POWER TYPE (Circle One):
Electric, Tractor, Diesel, Gasoline, Butane,
Other (Describe) 10 Gpm H/P 1

DESCRIPTION OF FORMATIONS ENCOUNTERED	FROM	TO
<u>Top soil & clay</u>	<u>0</u>	<u>18</u>
<u>Sand</u>	<u>18</u>	<u>105</u>
<u>Clay</u>	<u>105</u>	<u>220</u>
<u>Rock</u>	<u>220</u>	<u>222</u>
<u>Clay & Sand Strata</u>	<u>222</u>	<u>270</u>
<u>Sand</u>	<u>270</u>	<u>300</u>

RECEIVED

11 0 1 2004

BY: OLWIN

Top of Lap Pipe or Reduction in Casing

FEET IF TELESCOPED OR MORE THAN ONE SCREEN: USE BACK PAGE

WELL DATA

Well Depth Casing Diameter (In.) Casing Length (Ft.)
300 4" 260

Type of Casing Hole Depth Depth to Static Water Level
PVC 300 280

TYPE OF COMPLETION: (Circle One or More):
Gravel Packed, Underreamed, Telescoped,
Natural Development, Open Hole, Other
(Describe)

WELL GROUTED TO A DEPTH OF 10 FEET
Type Grout (circle one): Cement, Bentonite, or Mix

SCREEN DATA

Diameter - Inches Length - Feet Slot Size - Inches

Screen Type Depth to Bottom - Feet


I certify that the well was drilled, constructed and completed in accordance with all applicable Requirements of the Mississippi Department of Environmental Quality and/or the Mississippi Department of Health regulations and state laws.

Nelson Cain #374
Signature of Licensed Driller and License No.

6-28-04
Date

Additional Information Required On Back

If well telescopes please sketch and show depths.

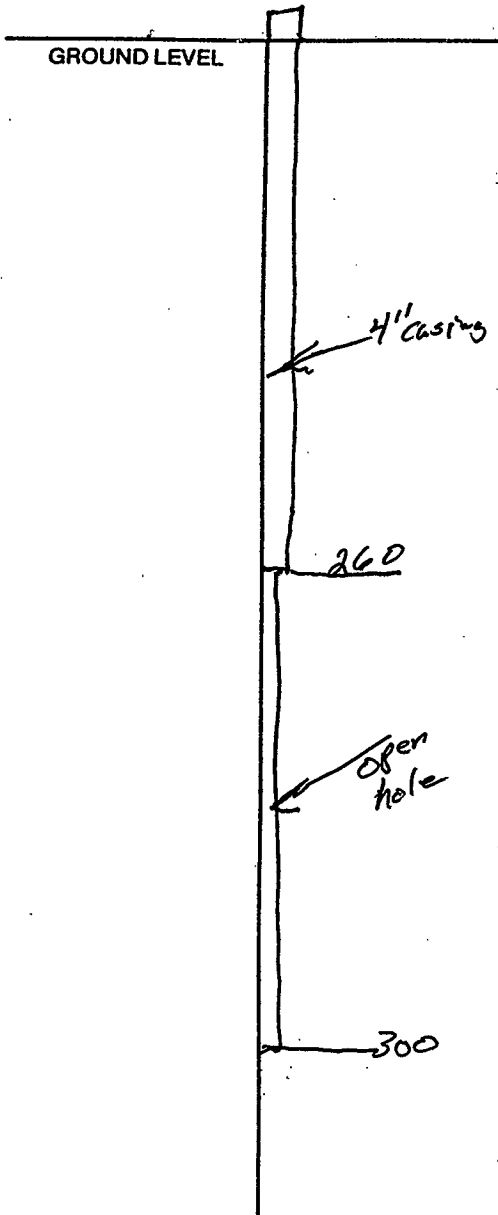

SECTION _____

Please indicate well location X.

Pump Capacity (GPM)	No. of Stages	Setting Depth	FT.
PUMP TEST			
Well yielded _____ GPM with			
a drawdown of _____ ft.			
after _____ hours of pumping			

LOG DATA

TYPE OF LOG RUN (Circle One): _____ No Log Run, Electric, Gamma Ray, Density, Sonic, Neutron, Other (Describe) _____

Name of Organization Running Log _____

GEOLOGIC DATA (Office Use Only)

Surface Elev.	Geologic Unit	Unit Thickness	Depth to Top
Subs. SWL	Date	Analysis	Aquifer Test

Driller's Remarks

If more than one screen, show location of each on sketch.