

Winston  
D 2000  
4 / 76

MISSISSIPPI  
BOARD OF WATER COMMISSIONERS  
416 North State Street  
Jackson, Mississippi 39201

WATER WELL DRILLERS LOG

April 19 76 <sup>13T</sup> Thomas & Son Winston  
date well completed firm name county well located

LANDOWNER: Season Cowstice  
Low's Ville, Miss  
(mailing address)


description of formations encountered	from	to
Red CLAY	0	5
PIPE CLAY	5	18
BLACK DIRT SAND	18	27
SAND	27	28
Blue CHALK	28	63
5 1/2" CHALK & COARSE SAND	63	84

WELL LOCATION:  
sec. 28 T. 15 N. R. 11 E  
S W  
5 1/2 miles W of Lewisville  
(distance) (direction) (nearest town)

WELL PURPOSE:  
 Home,  Irrigation,  municipal,  industrial

- WELL COMPLETION DATA:
- diameter (inches) 2
  - total depth (feet) 84
  - static water level (feet) 38 <sup>below</sup> <sub>above</sub> top of ground.
  - casing 1 1/2 74  
(material) (depth)  
2 if telescope see back.  
(size)
  - screen 10 74  
(length) (depth to top)  
2" 8 slot VC  
(size) (material)
  - pump 3/4 7  
(HP) (yield gpm)  
elec  
(type power)
  - electric log no  
(yes or no)
- (organization running log)
- (8) how well bottom plugged fair


DRILLERS REMARKS:

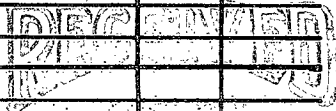

MAY 19 1976

If well telescopes please sketch and show depths.

GROUND LEVEL

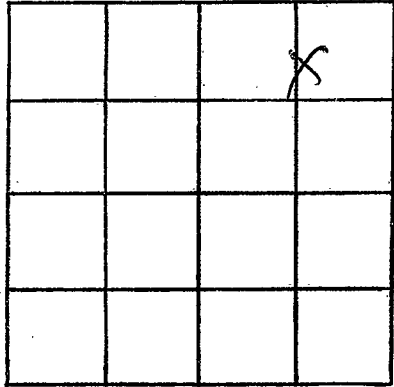

SECTION 28

Please indicate well location X.

ADDITIONAL INFORMATION

If more than one screen, show locations of each on sketch.