

WINSTON  
 D 2001  
 3/177

MISSISSIPPI  
 BOARD OF WATER COMMISSIONERS  
 416 North State Street  
 Jackson, Mississippi 39201

WATER WELL DRILLERS LOG

March 19 27 Thompson Son Winston  
 date well completed firm name county well located

LANDOWNER: B. Dempsey  
 Lewisville, Miss.  
 (mailing address)

description of formations encountered	from	to
Red Clay	0	10
SAND & CHALK	10	35
CHALK	35	42
SAND	42	52

WELL LOCATION:  
 sec. 29 T 15 N R 11 E  
 S W  
 5 1/2 miles W of Lewisville  
 (distance) (direction) (nearest town)

WELL PURPOSE:  
 (home, irrigation, municipal, industrial)

- WELL COMPLETION DATA:
- (1) diameter (inches) 2
  - (2) total depth (feet) 52
  - (3) static water level (feet) 20 below top of ground.
  - (4) casing PVC 45 (material) (depth)  
 2 (size) If telescope see back.
  - (5) screen 7 45 (length) (depth to top)  
 2 1/2 slot PVC (size) (material)
  - (6) pump 3/4 9 (HP) (yield gpm)  
 elec. (type power)
  - (7) electric log No (yes or no)
- (organization running log)
- (8) how well bottom plugged Point


DRILLERS REMARKS:

RECEIVED  
 APR 1 1971

MISS. RD. OF WATER COMMISSIONERS

If well telescopes please sketch and show depths.

GROUND LEVEL

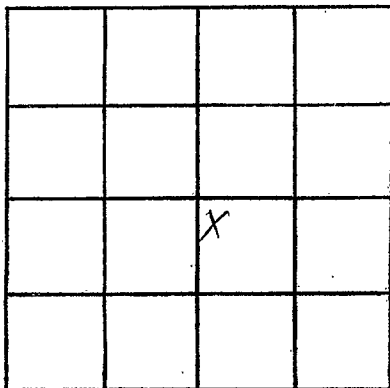

SECTION 29

Please indicate well location X.

ADDITIONAL INFORMATION

If more than one screen,  
show locations of each on sketch.