

WINSTON  
 D 2002  
 3/27/77

MISSISSIPPI  
 BOARD OF WATER COMMISSIONERS  
 416 North State Street  
 Jackson, Mississippi 39201

13T

WATER WELL DRILLERS LOG

March 27, 1977 The Mast Son Winston  
 date well completed firm name county well located

LANDOWNER:	description of formations encountered	from	to
Ricky Melton	Rice Clay	0	15
Lewisville, Miss	BLACK DIRT	15	42
(mailing address)	SAND	42	52

WELL LOCATION:  
 sec. 29 T 14 N S R 11 E W  
 5 1/2 miles W of Lewisville  
 (distance) (direction) (nearest town)

WELL PURPOSE:  
 (home, irrigation, municipal, industrial)

- WELL COMPLETION DATA:
- (1) diameter (inches) 2
  - (2) total depth (feet) 52
  - (3) static water level (feet) 20 <sup>below</sup> / <sub>above</sub> top of ground
  - (4) casing (material) PVC (depth) 45  
 2 (size) If telescope see back.
  - (5) screen (length) 7 (depth to top) 45  
 2" (size) 3/8 slot (material) PVC
  - (6) pump (HP) 1/2 (yield gpm) 7  
 Elco (type power)
  - (7) electric log No (yes or no)
  - (organization running log)
  - (8) how well bottom plugged port


DRILLERS REMARKS:

RECEIVED  
 APR 1 1977

MISS. BU. OF WATER CONTROL

If well telescopes please sketch and show depths.

GROUND LEVEL

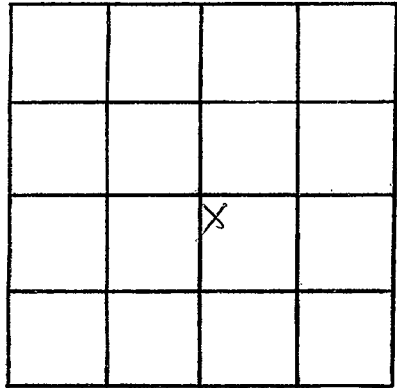

SECTION 29

Please indicate well location X.

ADDITIONAL INFORMATION

If more than one screen,  
show locations of each on sketch.