

Winston  
 D 2003  
 4-9-77

MISSISSIPPI  
 BOARD OF WATER COMMISSIONERS  
 416 North State Street  
 Jackson, Mississippi 39201

WATER WELL DRILLERS LOG

137  
 4-9-1977 date well completed  
 JH McDonald firm name  
 Winston county well located

LANDOWNER: J E Stevenson  
 Gausville, Miss.  
 (mailing address)  
 WELL LOCATION:  
 sec. 29 T 15 (N) R 11 (E)  
 7 miles west of Gausville  
 (distance) (direction) (nearest town)

description of formations encountered	from	to
red clay	0	25
gray clay	25	60
sandy clay	60	70
some water	70	75

WELL PURPOSE: Home  
 (home, irrigation, municipal, industrial)

- WELL COMPLETION DATA:
- (1) diameter (inches) 2
  - (2) total depth (feet) 75
  - (3) static water level (feet) 40 below top of ground.
  - (4) casing plastic, 70  
 (material) (depth)  
2" If telescope see back.  
 (size)
  - (5) screen 5, 75-70  
 (length) (depth to top)  
2" 8 slot PVC  
 (size) (material)
  - (6) pump 1, 8  
 (HP) (yield gpm)  
electronic  
 (type power)
  - (7) electric log             
 (yes or no)
- (organization running log)

(8) how well bottom plugged           


DRILLERS REMARKS:           

RECEIVED  
 MAY 3 - 1977

MISS. BD. OF WATER COMMISSIONERS

If well telescopes please sketch and show depths.

GROUND LEVEL

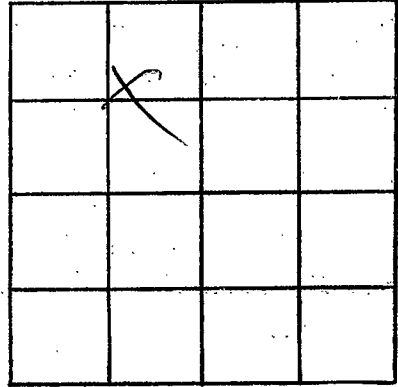

SECTION 29

Please indicate well location X.

ADDITIONAL INFORMATION

If more than one screen,  
show locations of each on sketch.