

**MISSISSIPPI DEPARTMENT OF NATURAL RESOURCES**  
**Bureau of Land and Water Resources**  
 Southport Mall  
 P.O. Box 10631  
 Jackson, Mississippi 39209  
**WATER WELL DRILLERS LOG**

WINSTON  
D 2004

3-25 1988 Thomas Drilling Winston  
 date well completed firm name county well located

LANDOWNER: Reed Kennedy  
Rt. 1 Box 166  
Louisville, MS  
 (mailing address)

description of formations encountered	from	to
<u>Brown dirt</u>	<u>0</u>	<u>8</u>
<u>White Sand</u>	<u>8</u>	<u>60</u>

WELL LOCATION:  
 sec. 30 T. 15 N. R. 11 E  
9 miles West of Louisville  
 (distance) (direction) (nearest town)

WELL PURPOSE: Home  
 (home, irrigation, municipal, industrial)

- WELL COMPLETION DATA:
- diameter (inches) 2"
  - total depth (feet) 60'
  - static water level (feet) 26 below above top of ground.
  - casing PVC, 50'  
 (material) (depth)  
2" if telescope see back.  
 (size)
  - screen 10', 50'  
 (length) (depth to top)  
2", PVC wrap  
 (size) (material)
  - pump 1 7  
 (HP) (yield gpm)  
Elec.  
 (type power)
  - electric log —  
 (yes or no)  
—  
 (organization running log)
  - how well bottom plugged —

**RECEIVED**


APR 15 1988

Department of Natural Resources  
 Bureau of Land & Water Resources

DRILLERS REMARKS: —

If well telescopes please  
sketch and show depths.

GROUND LEVEL

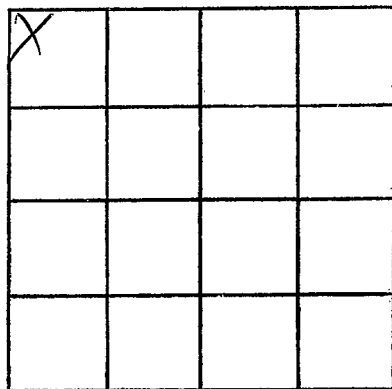

SECTION 30

Please indicate well location X.

ADDITIONAL INFORMATION

If more than one screen,  
show locations of each on sketch.