

157

CODED MISSISSIPPI  
 BOARD OF WATER COMMISSIONERS  
 416 North State Street  
 Jackson, Mississippi 39201

WATER WELL DRILLERS LOG

Winston  
 E 6  
 2-67

2-24 1967 Layne-Central Company Winston  
 date well completed firm name county well located

LANDOWNER: Southern Natural  
 Gas Company


description of formations encountered	from	to
Yellow Clay	0	20'
Blue Shale, stks. lignite	20	114
Rock	114	115
Hard shale, stks. lignite	115	130
Shale & Gumbo	130	285
Hard Packed Sand	285	298
Gumbo	298	350
Sand, stks. lignite	350	360
Gumbo	360	390
Sand	390	443
Sand, stks. of shale	443	453

Louisville, Mississippi  
 (mailing address)

WELL LOCATION: Compressor Station  
 sec. 28 T 15 N R 12 W S E  
 Louisville Compressor Station  
 miles of (distance) (direction) (nearest town)

WELL PURPOSE: Industrial  
 (home, irrigation, municipal, industrial)

- WELL COMPLETION DATA:
- (1) diameter (inches) 8"
  - (2) total depth (feet) 453'
  - (3) static water level (feet) 215' below top of ground.
  - (4) casing 8" 400' (material) (depth)
  - (size) if telescope see back.
  - (5) screen 40' 400' (length) (depth to top)
  - 6" stainless steel (size) (material)
  - (6) pump 25 150 (HP) (yield gpm)
  - electric (type power)
  - (7) electric log no (yes or no)
  - (organization running log)
  - (8) how well bottom plugged slugs

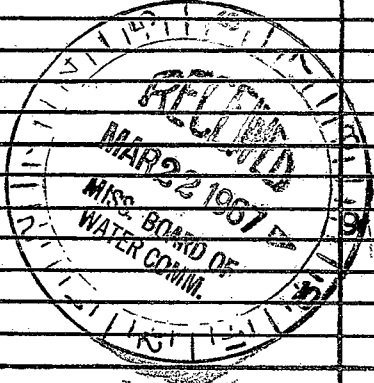

DRILLERS REMARKS:  
 10'7" of tail pipe on bottom

(7)

If well telescopes please sketch and show depths.

GROUND LEVEL

	X		

SECTION 28

Please indicate well location X.

ADDITIONAL INFORMATION

If more than one screen, show locations of each on sketch.