

Winston
EM
6-66

MISSISSIPPI BOARD OF WATER COMMISSIONERS
5 137
CODED WATER WELL DRILLERS LOG

Date: 6-20, 1966, Driller: T. b. Hare County: Winston
(Name)

(1) Owner of Land:	Description & Color of Materials Sand, Clay, Red Clay, Shell, etc.	Thick- ness Feet	Depth Feet
John Edwardward (Name) Louisville, Miss (Address)	top soil	1	1
	white clay	9	10
(2) Location: SE 1/4, NW 1/4, Sec. 32 T5 N R12 E	gray clay	12	22
2 miles west of Louisville (distance) (direction) (Nearest Town)	Blue clay + silt	8	30
(3) Topography: Hilly (Hilly) (Flat) (Level)	Blue sand	35	65
(4) Purpose of Well: planer mill Domestic Irrigation Municipal, Industrial, Other)			

Information upon completion of well:


- (1) Diameter 2 inches.
- (2) Total Depth 65 feet.
- (3) Water Level 15 feet below top of ground.
- (4) Cased to 30, Size 2"
- (5) Screen: Size open, Length _____
- (6) Were any formations sealed against pollution?

yes, no,

If YES depth of formation _____

Why _____

Drillers Remarks: I think the well is in this well

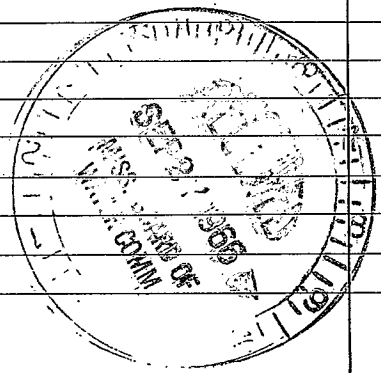

(Use Back Side)

Well No.

