

WINSTON 2 136
E8

CODED

WATER WELL DRILLERS LOG

Date: 8-23, 1963, Driller: MERRITT DRILLING County WINSTON
(Name CO.)

(1) Owner of Land: MISS. FORESTRY
Comm. Louisville
(Name) FIR TOWER
Louisville Miss.
(Address)

(2) Location: SW 1/4, SW 1/4, Sec. 8 T15 R12,
5 miles NORTH, of Louisville,
(distance) (direction) (Nearest Town)

(3) Topography: Hilly
(Hilly) (Flat) (Level)

(4) Purpose of Well: Domestic
(Domestic Irrigation
Municipal, Industrial, Other)

Description & Color of Materials Sand, Clay, Red Clay, Shell, etc.	Thick- ness Feet	Depth Feet
Red CLAY	0	3
SAND ROCK	3	3'6"
Red SAND	4	15
SAND + CLAY	15	21
PINK CLAY	21	25
Yellow CLAY	25	27
ROCK		4"
Blue CLAY	27	28
LIGNITE	28	30
Blue CLAY	30	48
LIGNITE	48	50
Blue CLAY	50	63
LIGNITE	63	64
Grey CLAY	64	100
LIGNITE	100	102
Blue CLAY, TRACE		
OF Blue SAND	102	126
Blue CLAY	126	130
LIGNITE	130	138
Blue CLAY	138	157
LIGNITE	157	158
Blue CLAY	158	162
SOFT GRAY CLAY	162	205
LIGNITE	205	206
SOFT BLUE CLAY	206	225
FINE GRAY SAND	225	231
White SAND	231	235
Very FINE SAND	235	260

Information upon completion of well:

(1) Diameter 2 inches.

(2) Total Depth 260 feet.

(3) Water Level 180' feet below top of ground.

(4) Cased to 233', Size 2".


(5) Screen: Size 2", Length 10'.

(6) Were any formations sealed against pollution?
yes, no.

If YES depth of formation _____

Why _____

Drillers Remarks: _____

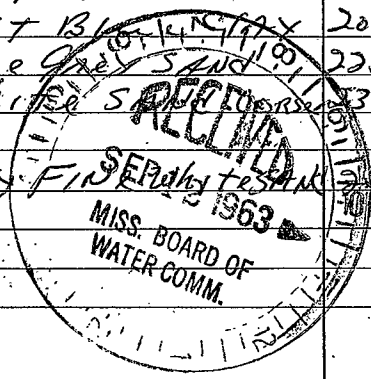

(Use Back Side)

Well No.

