

MISSISSIPPI BOARD OF WATER COMMISSIONERS

4 131 CODED

WATER WELL DRILLERS LOG

10
-15-62

Date: 11-15-62 Driller: J. L. Merritt County Winston
(Name)


(1) Owner of Land: C. L. McCullough
(Name)
114
(Address)
(2) Location: 1/4, 1/4, Sec. T R,
1 miles EAST, of Lowville
(distance) (direction) (Nearest Town)
(3) Topography: Hilly
(Hilly) (Flat) (Level)
(4) Purpose of Well: Domestic
(Domestic Irrigation) (Municipal, Industrial, Other)

Description & Color of Materials Sand, Clay, Red Clay, Shell, etc.	Thick- ness Feet	Depth Feet
Red clay		
Red clay	2	2.0
light		3.0
blue clay	30	33.0
light	55	57.0
Rock	59	58.0
blue clay	55	67.0
fine gravel	67	82.0
Medium C. sand	50	130.0

Information upon completion of well:

(1) Diameter 2 inches.
(2) Total Depth 132 feet.
(3) Water Level 80 feet below top of ground.
(4) Cased to 126, Size 2"
(5) Screen: Size 1 1/4", Length 6 ft.
(6) Were any formations sealed against pollution?
yes, no.

If YES depth of formation _____
Why _____
Drillers Remarks: _____

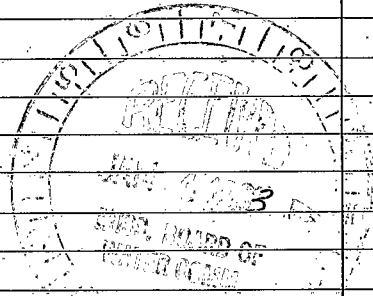

(Use Back Side)

Well No.

