

4 137 CODED

CODED

WATER WELL DRILLERS LOG

E300

E11  
10-28-60

Date: 10-28, 1960, Driller: J. H. McDonald County Winston  
(Name)

(1) Owner of Land: Paul Campbell  
(Name)  
Louisville Miss  
(Address)

(2) Location: 1/4, 1/4, Sec. 28 T R  
1 miles northwest of Louisville  
(distance) (direction) (Nearest Town)

(3) Topography: X  
(Hilly) (Flat) (Level)

(4) Purpose of Well: Domestic  
(Domestic Irrigation  
Municipal, Industrial, Other)

| Description & Color of Materials<br>Sand, Clay, Red Clay, Shell, etc. | Thick-<br>ness<br>Feet | Depth<br>Feet |
|---|------------------------|---------------|
| <u>red clay</u>   | <u>20</u>              | <u>20</u>     |
| <u>blue clay</u>  | <u>270</u>             | <u>290</u>    |
| <u>gray sand</u>  | <u>14</u>              | <u>304</u>    |

Information upon completion of well:

(1) Diameter 2 inches.

(2) Total Depth 304 feet.

(3) Water Level 160 feet below top of ground.

(4) Cased to 273? <sup>293?</sup>, Size 2"


(5) Screen: Size 1/4 90 gr. Length 10'

(6) Were any formations sealed against pollution?  
\_\_\_\_\_ yes, X no.

If YES depth of formation \_\_\_\_\_

Why \_\_\_\_\_

Drillers Remarks: \_\_\_\_\_

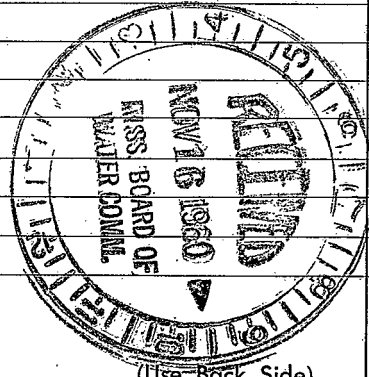

Well No.

137

