

Winston

MISSISSIPPI BOARD OF WATER COMMISSIONERS

Completed

CODED 5 137

4/24/69

WATER WELL DRILLERS LOG

JR

Date: 6-20, 1966, Driller: T. W. Hare County Winston

(Name)


(1) Owner of Land:	Description & Color of Materials Sand, Clay, Red Clay, Shell, etc.	Thick- ness Feet	Depth Feet
John Woodward (Name) Louisville Miss (Address)	top soil	0	1
Location: SW 1/4, SW 1/4, Sec. 32 T ¹⁵ N R ¹² E 2 miles West of Louisville (distance) (direction) (Nearest Town)	white clay	1	10
Topography: Hilly (Hilly) (Flat) (Level)	Gray Clay	10	22
Purpose of Well: Home (Domestic Irrigation Municipal, Industrial, Other)	Blue clay + silt	22	30
	Blue Sand	30	65

Information upon completion of well:

- (1) Diameter 2 inches.
- (2) Total Depth 65 feet.
- (3) Water Level 15 feet below top of ground.
- (4) Cased to 30, Size 2
- (5) Screen: Size open, Length
- (6) Were any formations sealed against pollution?
yes, no.

If YES depth of formation
Why

Drillers Remarks:

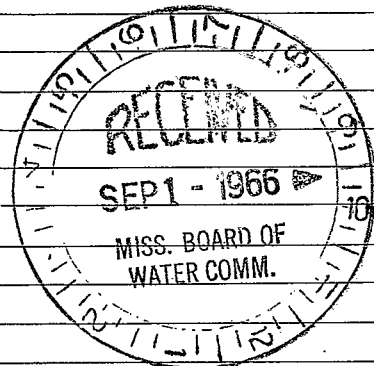

(Use Back Side)

Well No.

