

5 13 T CODED

WATER WELL DRILLERS LOG

Date: JAN 5, 1965, Driller: MERRITT Drilling County, WINSTON  
(Name)

(1) Owner of Land: JAMES COOPER  
(Name)  
  
(Address) 201512  
(2) Location: 1/4, 1/4, Sec. 21 T. R  
2 miles NORTH, of Louisville  
(distance) (direction) (Nearest Town)  
(3) Topography: Hilly  
(Hilly) (Flat) (Level)  
(4) Purpose of Well: DOMESTIC  
(Domestic Irrigation  
Municipal, Industrial, Other)

Description & Color of Materials Sand, Clay, Red Clay, Shell, etc.	Thick- ness Feet	Depth Feet
Red clay	0	10
<del>Blue clay</del>		
Lignite	11	13
Blue Gumbo	13	33
Lignite	33	34
Green clay sand	34	37
Blue clay	37	42
Lignite	42	43
Blue clay	43	72
Thin Rock		
Blue clay	72	99
Lignite	99	104
Blue clay	104	126
Lignite	126	129
Blue clay	129	143
Blue sand very fine	143	165
Blue clay & sand	165	180
Thin Rock		
Blue clay & sand	188	195
Blue clay	195	208
Hard blue clay & lignite	208	252
Hard blue clay & sand	252	272
Finer blue sand	272	295
Sand & rock	295	296
Blue clay & sand	296	307
Hard 6" rock		
Blue clay	307	312
Blue clay & lignite	312	338
Clay & sand	338	343
Hard lignite	343	347
Hard clay & lignite	347	355
Blue sand	355	404


Information upon completion of well:

(1) Diameter 2 inches.  
(2) Total Depth 404 feet.  
(3) Water Level 189 feet below top of ground.  
(4) Cased to 399, Size 2"  
(5) Screen: Size 1 1/4", Length 6  
(6) Were any formations sealed against pollution?  
\_\_\_\_\_ yes,  no.

If YES depth of formation \_\_\_\_\_

Why \_\_\_\_\_

Drillers Remarks: \_\_\_\_\_

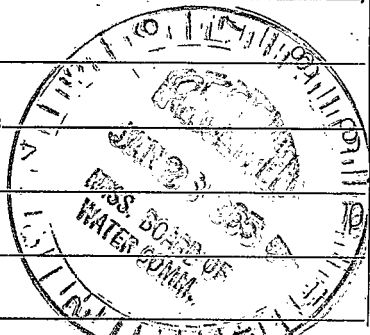

(Use Back Side)

Well No.

1000

1000

