

WINSTON

E 18

2-27-63

MISSISSIPPI BOARD OF WATER COMMISSIONERS

5 137

WATER WELL DRILLERS LOG

Date: 2-27, 1963, Driller: J. L. MERRITT County: WINSTON


(1) Owner of Land:	Description & Color of Materials Sand, Clay, Red Clay, Shell, etc.	Thick- ness Feet	Depth Feet
Elmo. Kuhn (Name)	Red CLAY.	0	20
Hy. 15 - Louisville Miss. (Address)	LIGNITE	20	26
181512 (Address)	Blue CLAY	36	37
2) Location: 1/4, 1/4, Sec. T. R. 5 miles North of Louisville (distance) (direction) (Nearest Town)	Rock	39	40
3) Topography: Hilly (Hilly) (Flat) (Level)	Blue CLAY	46	47
4) Purpose of Well: DOMESTIC (Domestic Irrigation Municipal, Industrial, Other)	Blue CLAY + trace of Blue SAND.	147	168
	Blue SAND.	168	232

Information upon completion of well:

- (1) Diameter 2 inches.
- (2) Total Depth 232 feet.
- (3) Water Level 168 feet below top of ground.
- (4) Cased to 189, Size 2"
- (5) Screen: Size Open, Length
- (6) Were any formations sealed against pollution?
yes, no.

If YES depth of formation Shale.
Why Trap At. 189'

Drillers Remarks:

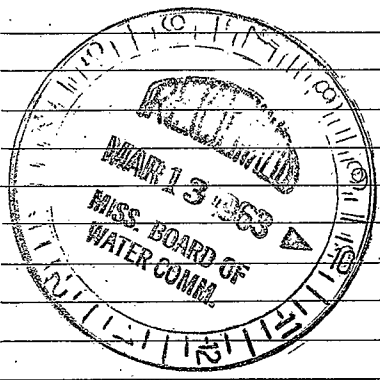

(Use Back Side)

Well No.

