

WINSTON

E 22

1-31-73

E Log # 29

1/31

date well completed

MISSISSIPPI
 BOARD OF WATER COMMISSIONERS
 416 North State Street
 Jackson, Mississippi 39201

CODED

WATER WELL DRILLERS LOG

1973 Singer-Lump Central Div Winston
 firm name county well located

LANDOWNER:
Southern Natural Gas Co.
Louisville, Miss.
 (mailing address)

WELL LOCATION:
 sec. 28 T 15 N R. 12 E
 (distance) miles of (direction) (nearest town)

WELL PURPOSE: Industrial
 (home, irrigation, municipal, industrial)

- WELL COMPLETION DATA:
- (1) diameter (inches) 12"
 - (2) total depth (feet) 443'
 - (3) static water level (feet) 224' below above top of ground.
 - (4) casing Steel 390'
 (material) (depth)
12" if telescope see back.
 (size) 68" 26"
 - (5) screen 42' 390'
 (length) (depth to top)
6" Stainless Steel
 (size) (material)
 - (6) pump 25 300
 (HP) (yield gpm)
Electric
 (type power)
 - (7) electric log Yes
 (yes or no)
Miss. Geo. Survey
 (organization running log)
 - (8) how well bottom plugged Valve

description of formations encountered	from	to
<u>Fill Dirt</u>	<u>0</u>	<u>8</u>
<u>Clay streaks, Rock</u>	<u>8</u>	<u>108</u>
<u>Sandy Shale</u>	<u>108</u>	<u>125</u>
<u>Clay (Lump) Rock Streaks</u>	<u>125</u>	<u>156</u>
<u>Hard Black Shale</u>	<u>156</u>	<u>254</u>
<u>Sandy Clay</u>	<u>254</u>	<u>261</u>
<u>Clay</u>	<u>261</u>	<u>284</u>
<u>Sand</u>	<u>284</u>	<u>295</u>
<u>Clay (Sandy)</u>	<u>295</u>	<u>312</u>
<u>Hard Clay</u>	<u>312</u>	<u>347</u>
<u>Sand + Shale Streaks</u>	<u>347</u>	<u>365</u>
<u>Clay</u>	<u>365</u>	<u>387</u>
<u>Sand</u>	<u>387</u>	<u>460</u>
<u>Sandy Clay</u>	<u>460</u>	<u>465</u>

CODED


DRILLERS REMARKS:

FEB 8 1973

(F)

If well telescopes please sketch and show depths.

GROUND LEVEL

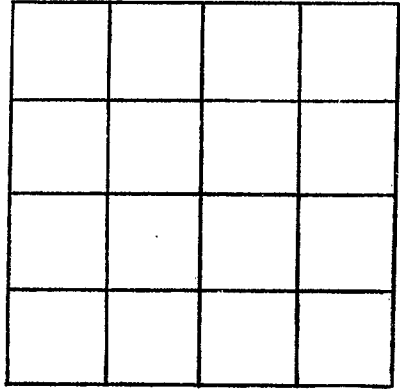

SECTION _____

Please indicate well location X.

ADDITIONAL INFORMATION

A series of horizontal lines for writing additional information.

If more than one screen, show locations of each on sketch.