

**WINSTON**  
**E 23**  
**4-17-74**

MISSISSIPPI  
 BOARD OF WATER COMMISSIONERS CODED  
 416 North State Street  
 Jackson, Mississippi 39201

**WATER WELL DRILLERS LOG**

4-17 1974 G H McDonald Winston  
 date well completed firm name county well located

LANDOWNER: Matt Tanner  
Louisville Miss  
 (mailing address)  
 WELL LOCATION:  
 sec. 3 T 15 (N) R 12 (E)  
4 miles north of Louisville  
 (distance) (direction) (nearest town)

description of formations encountered	from	to
<u>Red clay</u>	<u>0</u>	<u>18</u>
<u>gray clay</u>	<u>18</u>	<u>210</u>
<u>gray sand</u>	<u>210</u>	<u>216</u>

WELL PURPOSE: Home  
 (home, irrigation, municipal, industrial)

- WELL COMPLETION DATA:
- (1) diameter (inches) 2"
  - (2) total depth (feet) 216
  - (3) static water level (feet) 160 below above top of ground.
  - (4) casing steel 189'  
 (material) (depth)  
2" if telescope see back.  
 (size)
  - (5) screen 4' 216 212  
 (length) (depth to top)
  - 1 1/4 SS  
 (size) (material)
  - (6) pump 3/4 WH 5  
 (HP) (yield gpm)  
electric  
 (type power)
  - (7) electric log \_\_\_\_\_  
 (yes or no)
  - \_\_\_\_\_  
 (organization running log)
  - (8) how well bottom plugged \_\_\_\_\_


**CODED**

DRILLERS REMARKS: \_\_\_\_\_

**RECEIVED**  
 MAY 20 1974

If well telescopes please sketch and show depths.

GROUND LEVEL

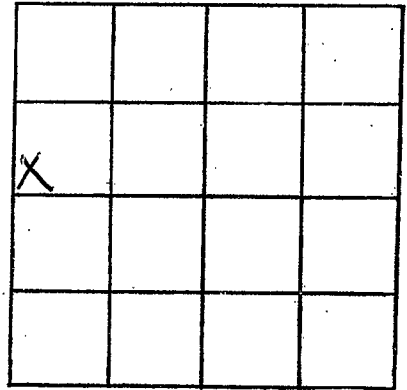

SECTION 3

Please indicate well location X.

ADDITIONAL INFORMATION

If more than one screen, show locations of each on sketch.