

Winston
 E 2000
 6-8-76



MISSISSIPPI
 BOARD OF WATER COMMISSIONERS
 416 North State Street
 13T Jackson, Mississippi 39201

WATER WELL DRILLERS LOG

6-8 1976 G. H. McDonald Winston
 date well completed firm name county well located

LANDOWNER: <u>Bill Yorkbrough</u>	Description of formations encountered	from	to
<u>Louisville Miss</u> <u>city</u> (mailing address)	<u>clay</u>	<u>0</u>	<u>20</u>
WELL LOCATION: sec. <u>33 T 15 N</u> R. <u>13 E</u>	<u>gray clay</u>	<u>20</u>	<u>328</u>
<u>0</u> miles <u>S.W.</u> of <u>Louisville</u> (distance) (direction) (nearest town)	<u>coarse sand</u>	<u>328</u>	<u>340</u>
WELL PURPOSE: <u>Water Flouren</u> (home, irrigation, municipal, industrial)	<u>gray clay</u>	<u>340</u>	<u>380</u>
WELL COMPLETION DATA: (1) diameter (inches) <u>4"</u>	<u>white sand</u>	<u>380</u>	<u>410</u>
(2) total depth (feet) <u>410</u>			
(3) static water level (feet) <u>135</u> below above top of ground.			
(4) casing <u>steel</u> <u>252</u> (material) (depth) <u>4'</u> if telescope see back. (size)			
(5) screen <u>20' (340-330)</u> <u>410-400</u> (length) (depth to top)			
<u>2"</u> <u>no slot</u> <u>SS</u> (size) (material)			
(6) pump <u>5</u> <u>60</u> (HP) (yield gpm) <u>electric</u> (type power)			
(7) electric log <u>no</u> (yes or no)			
(organization running log)			
(8) how well bottom plugged			
DRILLERS REMARKS:			

If well telescopes please sketch and show depths.

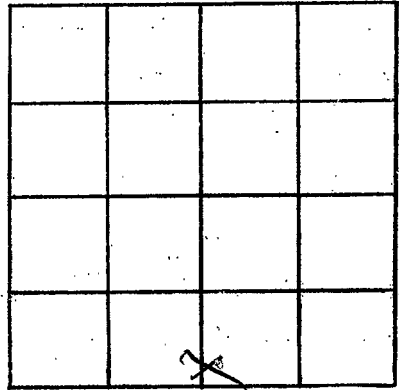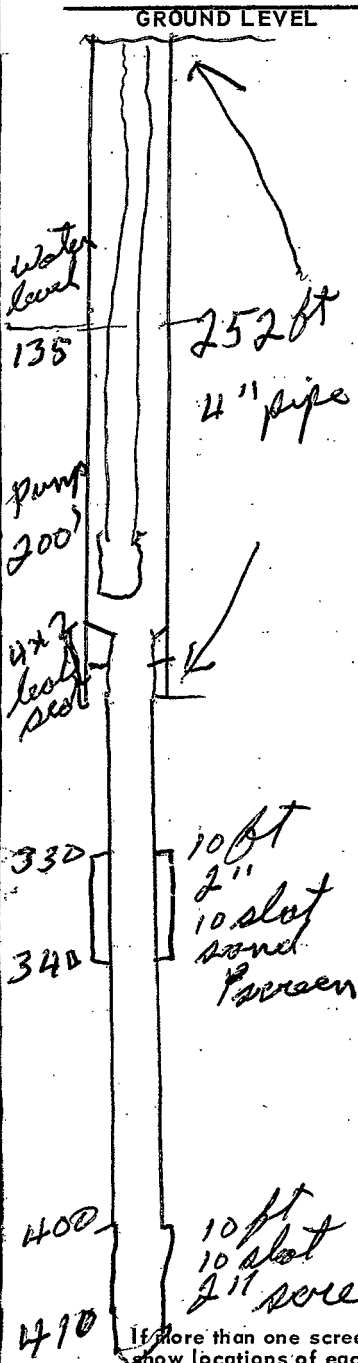

SECTION 33

Please indicate well location X.

ADDITIONAL INFORMATION

Horizontal lines for additional information.

If more than one screen, show locations of each on sketch.