

F3

5 13 T

CODED

3-25-65

WATER WELL DRILLERS LOG

Date: 3-25, 1965, Driller: MERRITT DAWLING of County WINSTON

(Name)

(1) Owner of Land: LOTTIE LOGAN
(Name)

4 1/4 EAST LOUISVILLE MISS
(Address) 33 1513

(2) Location: 1/4, 1/4, Sec. T R

4 miles EAST of LOUISVILLE
(distance) (direction) (Nearest Town)

(3) Topography: Hilly
(Hilly) (Flat) (Level)

(4) Purpose of Well: DOMESTIC
(Domestic Irrigation
Municipal, Industrial, Other)

Description & Color of Materials Sand, Clay, Red Clay, Shell, etc.	Thick- ness Feet	Depth Feet
TOP SOIL	0	1
Red CLAY	1	18
PINK CLAY	18	23
LIGNITE	23	46
Blue SAND	46	47
Blue CLAY	47	63
Dry SAND	63	110

Information upon completion of well:

(1) Diameter 2 inches.

(2) Total Depth 110' feet.

(3) Water Level 50' feet below top of ground.

(4) Cased to 105, Size 2


(5) Screen: Size 1 1/4, Length 5'

(6) Were any formations sealed against pollution?
_____ yes, _____ no.

If YES depth of formation _____

Why _____

Drillers Remarks: _____

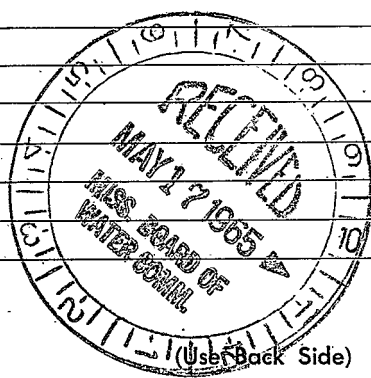

Well No.

