

WINSTON

MISSISSIPPI BOARD OF WATER COMMISSIONERS

B/F1

6 136 CODED

7-6-62

WATER WELL DRILLERS LOG

Date: 7-6, 1962, Driller: E.K. MERRITT County WINSTON (Name)

(1) Owner of Land: MARION C ROWE, II (Name)

Rfd. 5, Louisville, Miss 16 1513 (Address)

(2) Location: 1/4, 1/4, Sec. T R, 6 miles N-EAST of Louisville (distance, direction, Nearest Town)

(3) Topography: (Hilly) (Flat) (Level)

(4) Purpose of Well: DOMESTIC (Domestic Irrigation, Municipal, Industrial, Other)

Table with 3 columns: Description & Color of Materials (Sand, Clay, Red Clay, Shell, etc.), Thickness Feet, Depth Feet. Contains handwritten entries: Red Clay (0-30), FINE WHITE SAND (30-60), COARSE TAN SAND (60-70).

Information upon completion of well:

(1) Diameter 2 inches.

(2) Total Depth 75 feet.

(3) Water Level 50 feet below top of ground.

(4) Cased to 63, Size 2"


(5) Screen: Size 1/4, Length 6'

(6) Were any formations sealed against pollution? yes, no.

If YES depth of formation

Why

Drillers Remarks:

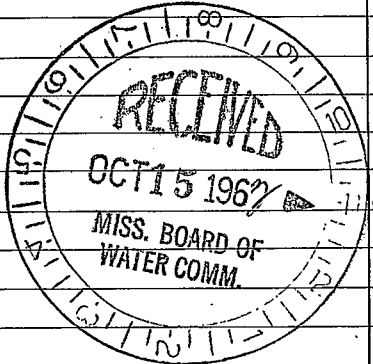

(Use Back Side)

Well No.

1947
The following is a list of the names of the persons who were present at the meeting held on the 15th day of June, 1947, at the residence of the undersigned, at the address of 1234 Main Street, New York, New York.

- Mr. J. Edgar Hoover
- Mr. E. A. Tamm
- Mr. Clegg
- Mr. Glavin
- Mr. Ladd
- Mr. Nichols
- Mr. Rosen
- Mr. Tracy
- Mr. Carson
- Mr. Egan
- Mr. Gurnea
- Mr. Hendon
- Mr. Pennington
- Mr. Quinn
- Mr. Nease
- Mr. Gandy
- Miss Gandy