

F10

6 13T

CODED

11-16-62

WATER WELL DRILLERS LOG

Date: 11-16, 19 62 Driller: J. L. Merrill County WINSTON

New over me dog (Name)

(1) Owner of Land: Bill Rhoads

(Name)

Rt. 5 Louisville

(Address)

8 15 13

(2) Location: 1/4, 1/4, Sec. 1 T R

4 miles North East of Louisville

(distance)

(direction)

(Nearest Town)

(3) Topography: Hilly

(Hilly)

(Flat)

(Level)

(4) Purpose of Well: Domestic

(Domestic Irrigation Municipal, Industrial, Other)

Description & Color of Materials Sand, Clay, Red Clay, Shell, etc.

Thick-ness Feet

Depth Feet

Red sand

5

Red clay

3 25

SAND ROCK

25 30

Fine yellow sand

30 40

White sand

40 60

Coarse sand

60 82

Information upon completion of well:

(1) Diameter 2 inches.

(2) Total Depth 95 feet?

(3) Water Level \_\_\_\_\_ feet below top of ground.

(4) Cased to 84, Size 2"

(5) Screen: Size 1/4" Length 6'


(6) Were any formations sealed against pollution?

yes,  no.

If YES depth of formation \_\_\_\_\_

Why \_\_\_\_\_

Drillers Remarks: \_\_\_\_\_

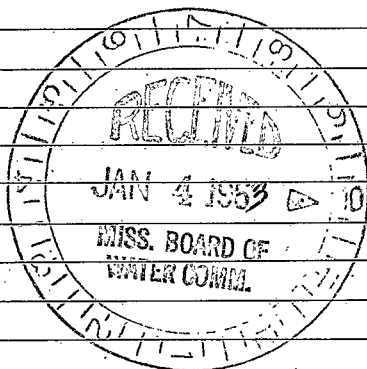

(Use Back Side)

Well No.

