

F12
2-14-61

5 13T

WATER WELL DRILLERS LOG

CODED

7

Date: 2/14, 1961, Driller: E. K. MORRIS County Winston
(Name)

(1) Owner of Land: Henry Millers
(Name)
Louisville, Miss.
(Address) 281513

(2) Location: 1/4, 1/4, Sec. T R. R.
5 miles NE of Louisville
(distance) (direction) (Nearest Town)

(3) Topography: (Hilly) (Flat) (Level)

(4) Purpose of Well: Domestic
(Domestic Irrigation
Municipal, Industrial, Other)

Description & Color of Materials Sand, Clay, Red Clay, Shell, etc.	Thick- ness Feet	Depth Feet
<u>Dark grey sand</u>	<u>0</u>	<u>17</u>
<u>Dark clay & sand</u>	<u>17</u>	<u>27</u>
<u>Med. fine grey sand</u>	<u>27</u>	<u>36</u>
<u>4" Rock at 36'</u>		
<u>Hard Ligrite</u>	<u>36</u>	<u>36</u>
<u>Med. Hard Grey Clay</u>	<u>36</u>	<u>42</u>
<u>Soft white clay</u>	<u>42</u>	<u>49</u>
<u>4" Rock at 49'</u>		
<u>Med. soft white clay</u>	<u>49</u>	<u>54</u>
<u>Med. Hard Ligrite</u>	<u>54</u>	<u>56</u>
<u>Hard Light Grey Clay</u>	<u>56</u>	<u>67</u>
<u>Soft Grey Clay</u>	<u>67</u>	<u>77</u>
<u>4" Rock at 77'</u>		
<u>Fine blue sand</u>	<u>77</u>	<u>84</u>
<u>4" Rock at 84'</u>		
<u>Soft red blue clay</u>	<u>84</u>	<u>100</u>
<u>Round sand (grey)</u>	<u>100</u>	<u>130</u>
<u>Med. fine grey sand</u>	<u>130</u>	<u>140</u>
<u>Coarse Tan Sand</u>	<u>140</u>	<u>159</u>
<u>Rock at 159'</u>		

Information upon completion of well:

(1) Diameter 2 inches.

(2) Total Depth 159 feet.

(3) Water Level 10 feet below top of ground.

(4) Cased to 157, Size 2


(5) Screen: Size 1/4, Length 6'

(6) Were any formations sealed against pollution?
_____ yes, _____ no.

If YES depth of formation _____

Why _____

Drillers Remarks: _____

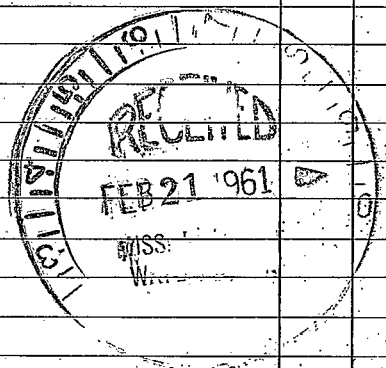

(Use Back Side)

Well No.

