

WATER WELL DRILLERS LOG

Date: 5-19, 19 64, Driller: MERRITT DRILLERS County WINSTON
Sheridan Reed Newowner (Name)

(1) Owner of Land: JAW SIMMONS
 (Name)
RT. 5. Louisville, Miss
 (Address)

(2) Location: 1/4, 1/4, Sec. 17 15 13 T 1 R 13
4 miles N.E, of Louisville
 (distance) (direction) (Nearest Town)

(3) Topography: Hilly
 (Hilly) (Flat) (Level)

(4) Purpose of Well: DOMESTIC
 (Domestic Irrigation
 Municipal, Industrial, Other)

Description & Color of Materials Sand, Clay, Red Clay, Shell, etc.	Thick- ness Feet	Depth Feet
Red CLAY	0	6
Blue CLAY	6	21
LIGNITE	21	23
Blue CLAY	23	45
Blue SAND	45	100
CLAY FINA		

Information upon completion of well:

(1) Diameter 2 inches.

(2) Total Depth 110 feet.

(3) Water Level 45 feet below top of ground.


(4) Cased to 105, Size 2

(5) Screen: Size 2, Length 5

(6) Were any formations sealed against pollution?
 _____ yes, _____ no.

If YES depth of formation 4" SURFACE
 Why @ ASING TO 19 FT.

Drillers Remarks:

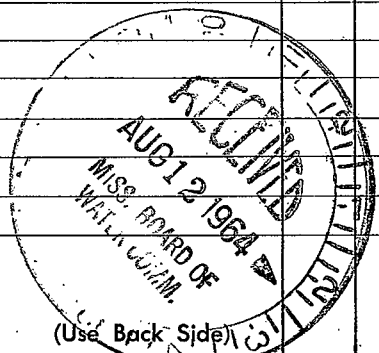

Well No.

1944 - 1945

1944 - 1945

1944 - 1945

1944 - 1945