

WINSTON
FD 17

6 136
WATER WELL DRILLERS LOG CODED

F

Date: 7/14/61, 1961, Driller: E. K. Merritt County Winston
7-14-61 (Name)

(1) Owner of Land: Maria Messer
(Name)
Laursville Miss. R 7 R
(Address) 8 15 13

(2) Location: $\frac{1}{4}$, $\frac{1}{4}$, Sec. 3 T 3 R 1
6 miles NE of Laursville
(distance) (direction) (Nearest Town)

(3) Topography: (Hilly) (Flat) (Level)

(4) Purpose of Well: Domestic
(Domestic Irrigation, Municipal, Industrial, Other)

Description & Color of Materials Sand, Clay, Red Clay, Shell, etc.	Thick- ness Feet	Depth Feet
<u>Surface Clay</u>	<u>0</u>	<u>21</u>
<u>Soft red + Brown clay</u>	<u>21</u>	<u>30</u>
<u>Soft blue clay</u>	<u>30</u>	<u>43</u>
<u>Soft blue clay, trace</u>	<u>43</u>	<u>52</u>
<u>of powder sand</u>	<u>43</u>	<u>68</u>
<u>3" Rock at 68</u>		
<u>Med. Hard blue clay</u>	<u>68</u>	<u>115</u>
<u>Soft blue clay</u>	<u>115</u>	<u>132</u>
<u>4" Rock at 132</u>		
<u>Med. Hard blue clay</u>	<u>132</u>	<u>141</u>
<u>3" Rock at 141</u>		
<u>Soft reddish clay</u>	<u>141</u>	<u>148</u>
<u>Fine powder sand</u>		
<u>Trace of reddish clay</u>	<u>148</u>	<u>164</u>
<u>+ sand rock</u>		
<u>Med. Coarse white</u>	<u>164</u>	<u>171</u>
<u>sand, trace of clay</u>		
<u>+ sand rock</u>		
<u>Hard rock at 171</u>		
<u>Did not penetrate</u>		

Information upon completion of well:

(1) Diameter 2 inches.

(2) Total Depth 171 feet.

(3) Water Level 150 feet below top of ground.

(4) Cased to 16 2/3, Size 2


(5) Screen: Size 1 1/2", Length 5'

(6) Were any formations sealed against pollution?
no.

If YES depth of formation _____

Why _____

Drillers Remarks: _____

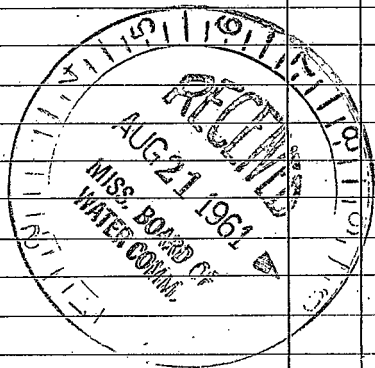

(Use Back Side)

Well No.

