

WINSTON

MISSISSIPPI BOARD OF WATER COMMISSIONERS

CODED

WATER WELL DRILLERS LOG

Date: 8-8, 1962, Driller: EK MERRITT County Winston

(1) Owner of Land: MRS. FRANCIS Peterson

(Name)

Louisville Miss

(Address)

91513

(2) Location: 1/4, 1/4, Sec. 9 T R

6 miles N.E. of Louisville

(distance)

(direction)

(Nearest Town)

(3) Topography: [check mark]

(Hilly)

(Flat)

(Level)

(4) Purpose of Well: Domestic

(Domestic Irrigation, Municipal, Industrial, Other)

Description & Color of Materials Sand, Clay, Red Clay, Shell, etc.

Thick-ness Feet

Depth Feet

Red clay 0 25

Blue clay 25 70

Fine yellow sand 70 100

Fine white sand 100 150

4" Rock 150 170

Red clay 170 175

4" Rock 175 185

Blue clay 185 185

Fine white sand 185 185

COARSE SAND 185 200

Information upon completion of well:

(1) Diameter 2" inches.

(2) Total Depth 210 feet.

(3) Water Level 63 feet below top of ground.

(4) Cased to 189, Size 2"

(5) Screen: Size 1 1/4", Length 6 ft.


(6) Were any formations sealed against pollution?

yes, [check mark] no.

If YES depth of formation

Why

Drillers Remarks:

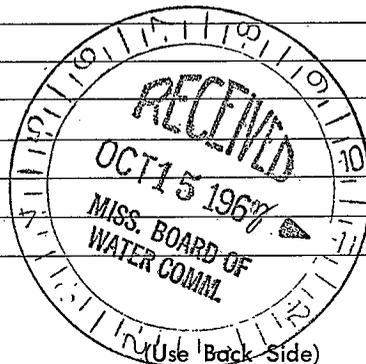

Well No.

