

MISSISSIPPI  
BOARD OF WATER COMMISSIONERS  
416 North State Street  
Jackson, Mississippi 39201

WATER WELL DRILLERS LOG

**CODED**

Winston  
R 19  
1-29-69

1-29-69  
date well completed

J. H. McDonald  
firm name

Winston  
county well located

LANDOWNER: Duster Washington

Description of formations encountered

from

to

Route 5

Red clay

140

Louisville Miss 39339  
(mailing address)

Chalk & Fine sand

40

80

WELL LOCATION:

White sand

80

95

sec. 11 T. 15 N. R. 13 E. W.

\_\_\_\_\_ miles \_\_\_\_\_ of \_\_\_\_\_  
(distance) (direction) (nearest town)

WELL PURPOSE:  
(home, irrigation, municipal, industrial)

WELL COMPLETION DATA:

(1) diameter (inches) 2"

(2) total depth (feet) 95'

(3) static water level (feet) 72' below above top of ground.

(4) casing 2" 91'  
(material) (depth)

**CODED**

\_\_\_\_\_ If telescope see back.  
(size)

(5) screen 4' 1 1/4" \_\_\_\_\_  
(length) (depth to top)

.08 \_\_\_\_\_  
(size) (material)

(6) pump 1/2 rod wt. 4  
(HP) (yield gpm)

E  
(type power)

(7) electric log no  
(yes or no)

\_\_\_\_\_ (organization running log)

(8) how well bottom plugged \_\_\_\_\_


MAY 23 1969

MISS. BD. OF WATER COMM.

DRILLERS REMARKS:

If well telescopes please sketch and show depths.

GROUND LEVEL

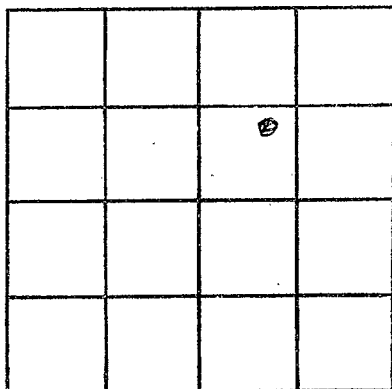

SECTION \_\_\_\_\_

Please indicate well location X.

ADDITIONAL INFORMATION

If more than one screen,  
show locations of each on sketch.