

MISSISSIPPI
 BOARD OF WATER COMMISSIONERS
 416 North State Street
 Jackson, Mississippi 39201



WATER WELL DRILLERS LOG

4-23-69
 date well completed

J. H. McParland
 firm name

Winston
 county well located

LANDOWNER: Grady Palmer

description of formations encountered

from to

Route 4
 Louisville, Miss
 (mailing address)

Red Clay		15
sand Chalk quies	15	35
white sand	35	47

WELL LOCATION:

sec. 1 T. 15 (N) S. R. 13 (E) W.
 8 miles East of Louisville
 (distance) (direction) (nearest town)

WELL PURPOSE:

(home, irrigation, municipal, industrial)

WELL COMPLETION DATA:


- (1) diameter (inches) 2
- (2) total depth (feet) 47
- (3) static water level (feet) 30 below top of ground.
- (4) casing 2" (material), 42' (depth)
 If telescope see back. (size)
- (5) screen 5 (length), (depth to top)
 60 ga 55 (size) (material)
- (6) pump 1/2 (HP), 5 1/2 (yield gpm)
 E (type power)
- (7) electric log (yes or no)
 (organization running log)
- (8) how well bottom plugged

MAY 23 1969
 MISS. BD. OF
 WATER COMM.

DRILLERS REMARKS:

If well telescopes please sketch and show depths.

GROUND LEVEL

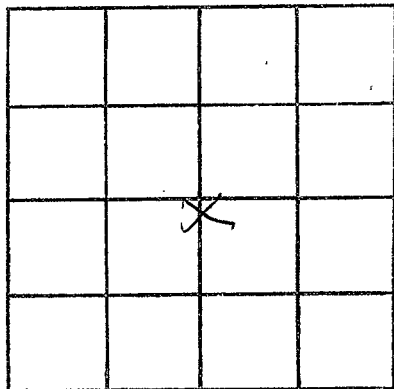

SECTION _____

Please indicate well location X.

ADDITIONAL INFORMATION

If more than one screen,
show locations of each on sketch.