

F23

6131

WATER WELL DRILLERS LOG

2-21-64

CODED

Date: 2-21, 19 64, Driller: Merritt Drilling County Winston

(Name)

(1) Owner of Land: JOHN O LIVINGSTON (Name) Louisville, Miss (Address) 7 15 13

(2) Location: 1/4, 1/4, Sec. T R, 5 miles NORTH of Louisville (distance) (direction) (Nearest Town)

(3) Topography: (Hilly) (Flat) (Level)

(4) Purpose of Well: DOMESTIC (Domestic Irrigation Municipal, Industrial, Other)

Description & Color of Materials Sand, Clay, Red Clay, Shell, etc.

Thick-ness Feet

Depth Feet

Red CLAY	0	20
Yellow CLAY	20	35
Blue CLAY	35	120
Blue SAND FINE	120	147


Information upon completion of well:

- (1) Diameter 2 inches.
- (2) Total Depth 147 feet.
- (3) Water Level 83 feet below top of ground.
- (4) Cased to 105, Size 2"
- (5) Screen: Size open, Length
- (6) Were any formations sealed against pollution? yes, no.

If YES depth of formation Skelet 147

Why

Drillers Remarks:

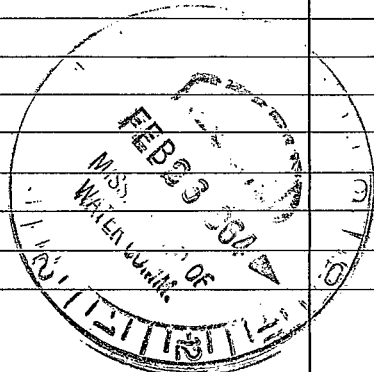

(Use Back Side)

Well No.

