

WINSTON
F27
9-19-73

MISSISSIPPI
 BOARD OF WATER COMMISSIONERS
 416 North State Street
 Jackson, Mississippi 39201

CODED

WATER WELL DRILLERS LOG

9-19-73 J. H. McDonald Winston
 date well completed firm name county well located

LANDOWNER: R. B. Coleman
Louisville Miss
 (mailing address)

description of formations encountered	from	to
<u>Red clay</u>	<u>0</u>	<u>20</u>
<u>pipe & sand</u>	<u>20</u>	<u>41</u>
<u>yellow. sand</u>	<u>41</u>	<u>46</u>

WELL LOCATION:
 sec. 1 T 15 N R 13 E
7 1/4 miles 9. E of Louisville
 (distance) (direction) (nearest town)

WELL PURPOSE: Home
 (home, irrigation, municipal, industrial)

- WELL COMPLETION DATA:
- (1) diameter (inches) 2"
 - (2) total depth (feet) 47'
 - (3) static water level (feet) 40 below above top of ground.
 - (4) casing steel, 42 (material) (depth)
2" If telescope see back. (size)
 - (5) screen 5', 47-42 (length) (depth to top)
1/4", S.S. Slot (size) (material)
 - (6) pump 1 4 (HP) (yield gpm)
electric (type power)
 - (7) electric log no (yes or no)
- (organization running log)
- (8) how well bottom plugged _____


CODED

DRILLERS REMARKS: _____

REC 26 1973
 MISS. DEP. OF
 WATER RESOURCES

If well telescopes please sketch and show depths.

GROUND LEVEL

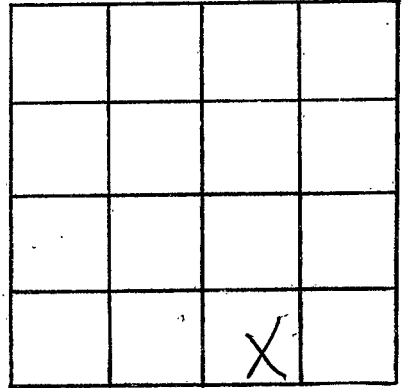

SECTION ~~X~~

Please indicate well location X.

ADDITIONAL INFORMATION

If more than one screen, show locations of each on sketch.