

WINTON

F 28

7-8-74

MISSISSIPPI BOARD OF WATER COMMISSIONERS **CODED**  
 416 North State Street  
 Jackson, Mississippi 39201

WATER WELL DRILLERS LOG

7-8 1974 Wm. Donald Winton  
 date well completed firm name county well located


LANDOWNER: <u>Calvin Coleman</u> <u>Louisville Miss</u>	description of formations encountered	from	to
(mailing address)	<u>Red clay</u>	<u>0</u>	<u>24</u>
WELL LOCATION: sec. <u>1</u> T. <u>15</u> N. R. <u>13</u> E S W	<u>pipe clay &amp; sand</u>	<u>24</u>	<u>60</u>
<u>8</u> miles <u>East</u> of <u>Louisville</u> (distance) (direction) (nearest town)	<u>white sand</u>	<u>60</u>	<u>65</u>
WELL PURPOSE: <u>Home</u> (home, irrigation, municipal, industrial)			
WELL COMPLETION DATA:			
(1) diameter (inches) <u>2 1/2</u>			
(2) total depth (feet) <u>65</u>			
(3) static water level (feet) <u>58</u> below/above top of ground.			
(4) casing <u>PVC</u> , <u>60</u> (material) (depth)			
<u>2 1/2</u> (size) If telescope see back.			
(5) screen <u>5'</u> , <u>65</u> <u>60</u> (length) (depth to top)			
<u>1 1/2</u> <u>10</u> <u>st</u> <u>SS</u> (size) (material)			
(6) pump <u>1</u> <u>5</u> (HP) (yield gpm)			
<u>electrical</u> (type power)			
(7) electric log <u>no</u> (yes or no)			
(organization running log)			
(8) how well bottom plugged			
DRILLERS REMARKS:			

RECEIVED  
 RECEIVED

AUG 26 1974

If well telescopes please sketch and show depths.

GROUND LEVEL

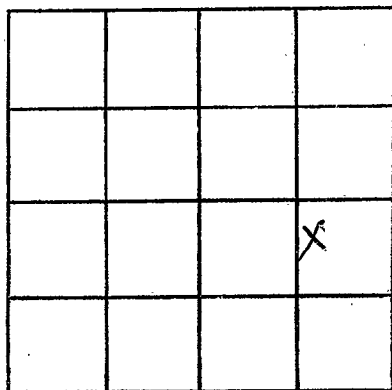

SECTION 1

Please indicate well location X.

ADDITIONAL INFORMATION

If more than one screen, show locations of each on sketch.