

WINSTON
F29
7-2-74

MISSISSIPPI
 BOARD OF WATER COMMISSIONERS
 416 North State Street
 Jackson, Mississippi 39201

CODED

WATER WELL DRILLERS LOG

7-2 1974 J H McDonald Winston
 date well completed firm name county well located

LANDOWNER: <u>Lee C. Coleman</u>	description of formations encountered	from	to
<u>Louisville, Miss</u>	<u>Red clay</u>	0	25
(mailing address)	<u>pipe clay & sand</u>	25	70
WELL LOCATION:	<u>white</u>	70	76
sec. <u>1</u> T <u>15</u> (N) S <u>3</u> R <u>13</u> (E) W			
<u>8</u> miles <u>East</u> of <u>Louisville</u> (distance) (direction) (nearest town)			
WELL PURPOSE: <u>Home</u> (home, irrigation, municipal, industrial)			
WELL COMPLETION DATA:			
(1) diameter (inches) <u>2"</u>			
(2) total depth (feet) <u>76</u>			
(3) static water level (feet) <u>65</u> below above top of ground.			
(4) casing <u>PVC</u> , <u>70</u> , (material) (depth)			
<u>2"</u> (size) if telescope see back.			
(5) screen <u>5'</u> , <u>75</u> <u>70</u> (length) (depth to top)			
<u>1 1/4" galv</u> , <u>59</u> (size) (material)			
(6) pump <u>1</u> , <u>2</u> (HP) (yield gpm)			
<u>electric</u> (type power)			
(7) electric log <u>no</u> (yes or no)			
(organization running log)			
(8) how well bottom plugged			
DRILLERS REMARKS:			


RECEIVED
 MISSISSIPPI
 BOARD OF WATER COMMISSIONERS

MIC 28 19/74

MISS. BD. OF WATER COMMISSIONERS

If well telescopes please sketch and show depths.

GROUND LEVEL

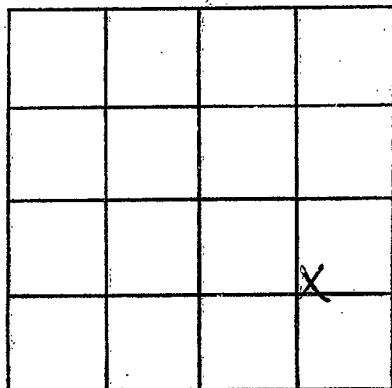

SECTION 1

Please indicate well location X.

ADDITIONAL INFORMATION

If more than one screen, show locations of each on sketch.