

WINSTON  
F 30  
7-15-74

MISSISSIPPI CODED  
BOARD OF WATER COMMISSIONERS  
416 North State Street  
Jackson, Mississippi 39201

WATER WELL DRILLERS LOG

7-15 1974 G. H. McDonald Winston  
date well completed firm name county well located

LANDOWNER: Bill Kestump  
Louisville Miss

description of formations encountered	from	to
red clay	8	25
pipe clay sand	25	45
white sand	45	50

(mailing address)

WELL LOCATION:

sec. 1 T15N R13E  
S W  
8 1/2 miles East of Louisville  
(distance) (direction) (nearest town)

WELL PURPOSE: Home  
(home, irrigation, municipal, industrial)

WELL COMPLETION DATA:

- (1) diameter (inches) 2"
- (2) total depth (feet) 50
- (3) static water level (feet) 40 below top of ground.
- (4) casing PVC, 45' (material) (depth)  
2" (size) if telescope see back.
- (5) screen 5' length, 50-45' depth to top  
1/4" slot SS (size) (material)
- (6) pump 1 HP, 5 (yield gpm)  
electrical (type power)
- (7) electric log no (yes or no)

(organization running log)

(8) how well bottom plugged

DRILLERS REMARKS:




AUG 8 1974

MISS. Bd. of Water Comm

If well telescopes please  
sketch and show depths.

GROUND LEVEL

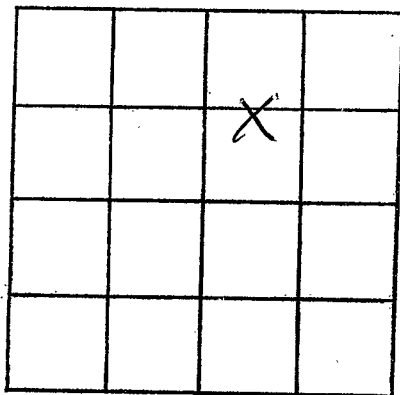

SECTION 1

Please indicate well location X.

ADDITIONAL INFORMATION

If more than one screen,  
show locations of each on sketch.