

WINSTON
F 31
3-5-75

MISSISSIPPI
 BOARD OF WATER COMMISSIONERS
 416 North State Street
 Jackson, Mississippi 39201

CODED

WATER WELL DRILLERS LOG

3-5 1975 G.H.M. Donald Winston
 date well completed firm name county well located

LANDOWNER: H.W. Harris
Louisville Miss
 (mailing address)
 WELL LOCATION:
 sec. 1 T. 15 (N) R. 13 (E)
8 miles East of Louisville
 (distance) (direction) (nearest town)

description of formations encountered	from	to
<u>red clay</u>	<u>0</u>	<u>30</u>
<u>clay + sand</u>	<u>30</u>	<u>62</u>
<u>yellow sand</u>	<u>62</u>	<u>70</u>

WELL PURPOSE: Home
 (home, irrigation, municipal, industrial)

WELL COMPLETION DATA:
 (1) diameter (inches) 2"
 (2) total depth (feet) 70
 (3) static water level (feet) 50 below above top of ground.
 (4) casing PVC, 63
 (material) (depth)
2" If telescope see back.
 (size)
 (5) screen 6', 69 63
 (length) (depth to top)
2" slat PVC
 (size) (material)
 (6) pump 1 4
 (HP) (yield gpm)
electric
 (type power)
 (7) electric log no
 (yes or no)
 (organization running log)
 (8) how well bottom plugged _____

DRILLERS REMARKS:


COPIED

RECEIVED
 MAR 17 1975

MISS. Bd. of Water Comm.

If well telescopes please sketch and show depths.

GROUND LEVEL

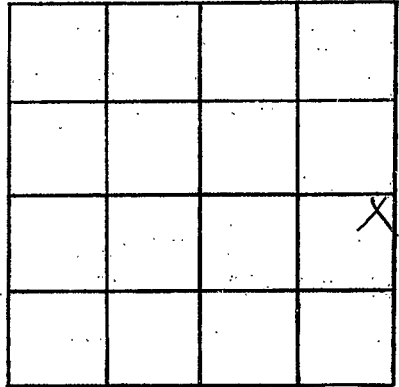

SECTION 1

Please indicate well location X.

ADDITIONAL INFORMATION

If more than one screen, show locations of each on sketch.