

WINSTON
F34
5-28-81

MISSISSIPPI
BOARD OF WATER COMMISSIONERS CODED
416 North State Street
Jackson, Mississippi 39201

WATER WELL DRILLERS LOG

5-28 19 81 THOMAS WINSTON
date well completed firm name county well located

LANDOWNER: Judge PRISACK
LOUISVILLE, MS.
(mailing address)

description of formations encountered	from	to
Pipe Clay	0	20
SOFT DREY CHALK	20	30
HARDEN " "	30	90
FINE SILTY SAND CHALK	90	110
FINE SAND CHALK + SILT	110	130
Good Course SAND	130	146
	146	183

WELL LOCATION:
sec. 17 T. 15 N. R. 13 E.
S W
3 miles NE of Louisville
(distance) (direction) (nearest town)

WELL PURPOSE:
(home, irrigation, municipal, industrial)

WELL COMPLETION DATA:

(1) diameter (inches) 6

(2) total depth (feet) 183

(3) static water level (feet) 50 below top of ground.

(4) casing PVC, 153, (material) (depth)
6 (size) if telescope see back.

(5) screen 30, 153 (length) (depth to top)
6" 32 slot PVC (size) (material)


(6) pump 5, 100 (HP) (yield gpm)
elec (type power)

(7) electric log NO (yes or no)

(organization running log)

(8) how well bottom plugged POINT


DRILLERS REMARKS:

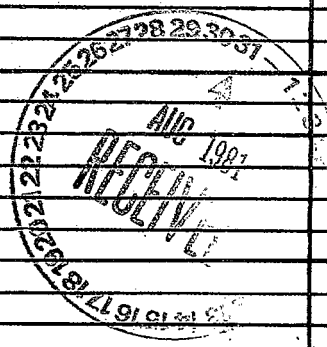

ⓧ

If well telescopes please sketch and show depths.

GROUND LEVEL

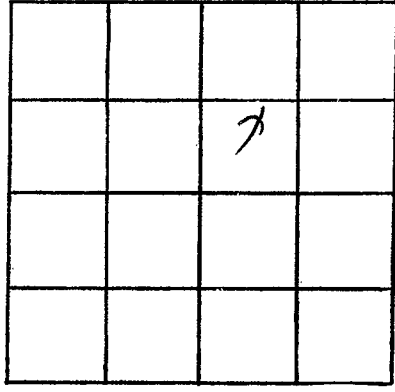

SECTION 17

Please indicate well location X.

ADDITIONAL INFORMATION

Lined area for additional information.

If more than one screen, show locations of each on sketch.