

Winston
 F35
 8/27/82

MISSISSIPPI
 BOARD OF WATER COMMISSIONERS
 416 North State Street
 Jackson, Mississippi 39201

CODED

WATER WELL DRILLERS LOG

Aug 27 1982 date well completed
 Thomas Drilling firm name
 Winston county well located

LANDOWNER:
 Grace Christian School
 Louisville, Miss
 (mailing address)

description of formations encountered	from	to
Red DIRT	0	10
Red CLAY	10	30
Gray chalk	30	48
Little Rock	48	48
Gray CHALK	48	90
Fine SAND + CHALK	90	120
Fine MIX White SAND	120	130
MIX SAND Fine + Heavy	130	180

WELL LOCATION:
 sec. 17 T15 N R13 E
 S W
 3 miles NE of Louisville
 (distance) (direction) (nearest town)

WELL PURPOSE:
 (home, irrigation, municipal, industrial)

- WELL COMPLETION DATA:
- (1) diameter (inches) 4
 - (2) total depth (feet) 180
 - (3) static water level (feet) 50 ^{below} _{above} top of ground.
 - (4) casing PVC 150
 (material) (depth)
 - 4 if telescope see back.
 (size)
 - (5) screen 30 150
 (length) (depth to top)
 - 4 PVC
 (size) (material)
 - (6) pump 1 sub 27
 (HP) (yield gpm)
 - Electric
 (type power)
 - (7) electric log NO
 (yes or no)

DEPT. OF NATURAL RESOURCES
 BUREAU OF LAND & WATER RESOURCES

SEP - 7 1982


RECEIVED

(organization running log)
 (8) how well bottom plugged screen

DRILLERS REMARKS:

If well telescopes please sketch and show depths.

GROUND LEVEL

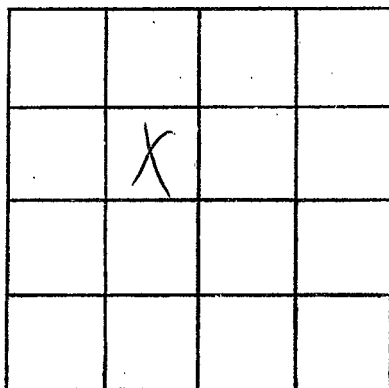

SECTION _____

Please indicate well location X.

ADDITIONAL INFORMATION

If more than one screen,
show locations of each on sketch.