

Winston

MISSISSIPPI  
BOARD OF WATER COMMISSIONERS  
416 North State Street  
Jackson, Mississippi 39201

F 2000  
8-20-79

79 WATER WELL DRILLERS LOG

8-20 1979 JH McDonald Winston  
date well completed firm name county well located

LANDOWNER: Joe ~~McDonald~~  
Crawson  
Laurieville Miss.

description of formations encountered  
red clay from 0 to 30

(mailing address)

lignite 30 32

WELL LOCATION:  
sec 31 T15 N R 13 E  
S W  
2 miles East of Laurieville  
(distance) (direction) (nearest town)

soil pipe clay 32 90  
water soil 90 118

WELL PURPOSE: Home  
(home, irrigation, municipal, industrial)

WELL COMPLETION DATA:

- (1) diameter (inches) 2"
- (2) total depth (feet)
- (3) static water level (feet) 80 below top of ground
- (4) casing POC 112  
(material) (depth)  
2" If telescope see back.  
(size)
- (5) screen 5' 118-113  
(length) (depth to top)  
1/4" o/slat S.S.  
(size) (material)
- (6) pump 1 b  
(HP) (yield gpm)
- electric  
(type power)
- (7) electric log no  
(yes or no)

(organization running log)


(8) how well bottom plugged

DRILLERS REMARKS:

DEPT. OF NATURAL RESOURCES  
BUREAU OF LAND & WATER RESOURCES  
JUL 30 1980  
RECEIVED

If well telescopes please  
sketch and show depths.

GROUND LEVEL

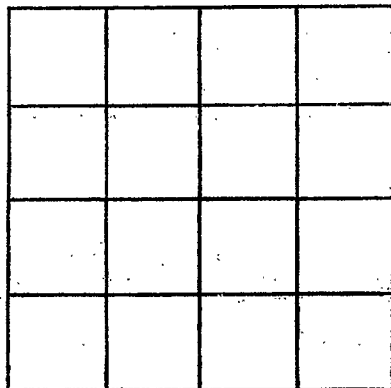

SECTION \_\_\_\_\_

Please indicate well location X.

ADDITIONAL INFORMATION

If more than one screen,  
show locations of each on sketch.