

3 137

CODED.

Winston
GG2
4-68

MISSISSIPPI
 BOARD OF WATER COMMISSIONERS
 416 North State Street
 Jackson, Mississippi 39201

WATER WELL DRILLERS LOG

#-20 1968 J. McDonald Winston
 date well completed firm name county well located

LANDOWNER:
Hornie Ardman
Sandow Road
 (mailing address)

description of formations encountered	from	to
<u>Clay</u>	<u>0'</u>	<u>4'</u>
<u>Sand</u>	<u>4'</u>	<u>57'</u>

WELL LOCATION:
 sec. 30 T. 15 N. R. 14 E.
10 miles E of Leucisville
 (distance) (direction) (nearest town)

WELL PURPOSE: HOME
 (home, irrigation, municipal, industrial)

- WELL COMPLETION DATA:
- (1) diameter (inches) 2"
 - (2) total depth (feet) 57'
 - (3) static water level (feet) 35 below above top of ground.
 - (4) casing 53' 57'
 (material) (depth)
NONE If telescope see back.
 (size)
 - (5) screen 4'
 (length) (depth to top)
1/4" Stainless Steel
 (size) (material)
 - (6) pump NONE NONE
 (HP) (yield gpm)
NONE
 (type power)
 - (7) electric log NO
 (yes or no)
 - (organization running log)
 - (8) how well bottom plugged


MAY 10 1968

DRILLERS REMARKS:

MISS. BD. OF
WATER COMM.

If well telescopes please sketch and show depths.

GROUND LEVEL

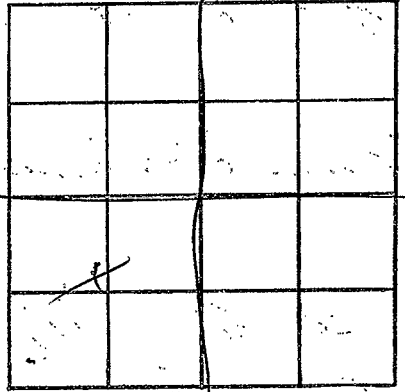

SECTION 35 W

Please indicate well location X.

ADDITIONAL INFORMATION

If more than one screen, show locations of each on sketch.