

✓
CODED

Winston
G3
12-4-68

MISSISSIPPI
BOARD OF WATER COMMISSIONERS
416 North State Street
Jackson, Mississippi 39201
WATER WELL DRILLERS LOG

12-4 1968 J. H. McDONALD WINSTON
date well completed firm name county well located

LANDOWNER: CARVEL EAVES

description of formations encountered from to

LOUISVILLE, MISS.
(mailing address)

CLAY 30'
CHALK & SAND 30' 100'
WHITE COARSE SAND 100 120'

WELL LOCATION:
sec 32 T. 15 N. R. 14 E
S W

WELL PURPOSE:
(home, irrigation, municipal, industrial)

WELL COMPLETION DATA:

- (1) diameter (inches) 2'
- (2) total depth (feet) 115'
- (3) static water level (feet) 100 below top of ground.
- (4) casing GALV. 110 (material), (depth)
- 2 (size) if telescope see back.
- (5) screen 4' (length), 113' (depth to top)
- 1 1/4" (size), 10-SLOT S.S. (material)
- (6) pump L.H.P. Jet 5 1/2 (HP) (yield gpm)
- Elec. (type power)
- (7) electric log NO (yes or no)

(organization running log)

JAN 31 1969


(8) how well bottom plugged

MISS. BD. OF WATER CONTROL

DRILLERS REMARKS:

If well telescopes please sketch and show depths.

GROUND LEVEL

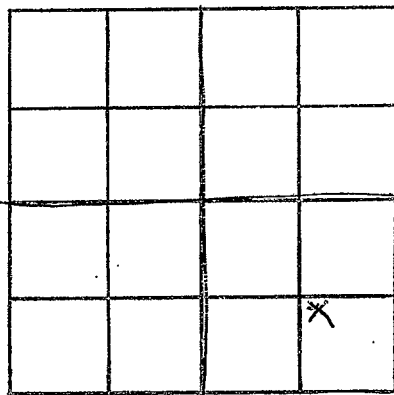

SECTION 32

Please indicate well location X.

ADDITIONAL INFORMATION

If more than one screen, show locations of each on sketch.