

WINSTON  
G5  
6-2-71

MISSISSIPPI  
BOARD OF WATER COMMISSIONERS  
416 North State Street  
Jackson, Mississippi 39201

**CODED**

WATER WELL DRILLERS LOG

6-2-71 date well completed 1971 J. H. McDonald firm name Winston county well located

LANDOWNER: Johnie Fullerton  
Louisville Miss  
(mailing address)

description of formations encountered	from	to
<u>red clay</u>	<u>0</u>	<u>10</u>
<u>sand white</u>	<u>10</u>	<u>50</u>

WELL LOCATION:  
sec. 6 T. 15 N. R. 14 E.  
7 miles E of Louisville  
(distance) (direction) (nearest town)

WELL PURPOSE: Home  
(home, irrigation, municipal, industrial)

WELL COMPLETION DATA:

(1) diameter (inches) 2"

(2) total depth (feet) 50

(3) static water level (feet) 20 below top of ground.

(4) casing Pvc. 34  
(material) (depth)

~~1 1/2~~ If telescope see back.  
(size)

(5) screen 5ft. 39-34  
(length) (depth to top)

1 1/2 SS (60 gr)  
(size) (material)

(6) pump 1 8  
(HP) (yield gpm)

electric  
(type power)

(7) electric log no  
(yes or no)

(organization running log)

(8) how well bottom plugged

**CODED**


MAY 8 - 1972

DRILLERS REMARKS: good  
sand & good  
water

MISSISSIPPI BOARD OF WATER COMMISSIONERS  
416 NORTH STATE STREET  
JACKSON, MISSISSIPPI 39201

If well telescopes please sketch and show depths.

GROUND LEVEL

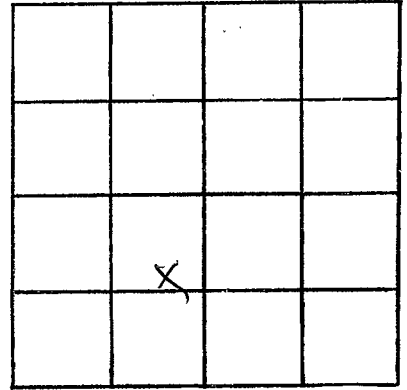

SECTION 6

Please indicate well location X.

ADDITIONAL INFORMATION

If more than one screen,  
show locations of each on sketch.