

WINTON
 GS
 7-11-74

MISSISSIPPI
 BOARD OF WATER COMMISSIONERS
 416 North State Street
 Jackson, Mississippi 39201

CODED

WATER WELL DRILLERS LOG

7-11 1974 G. H. McDonald Winston
 date well completed firm name county well located

LANDOWNER: Mt Bell Church
 Lousville Miss
 (mailing address)

description of formations encountered	from	to
Red clay	5	5
pipe clay	5	24
white gravel	24	30

WELL LOCATION:
 sec. 7 T 15 N R 11 E
 9 miles East of Lousville
 (distance) (direction) (nearest town)

WELL PURPOSE: church
 (home, irrigation, municipal, industrial)


- WELL COMPLETION DATA:
- (1) diameter (inches) 2"
 - (2) total depth (feet) 30
 - (3) static water level (feet) 20 below top of ground.
 - (4) casing PVC 24 (material) (depth)
 2" (size) If telescope see back.
 - (5) screen 5' 29 24 (length) (depth to top)
 1/4 10 slot 55 (size) (material)
 - (6) pump 1 4 (HP) (yield gpm)
 electric (type power)
 - (7) electric log no (yes or no)
 (organization running log)
 - (8) how well bottom plugged

DRILLERS REMARKS:

RECEIVED
 AUG 28 1974

If well telescopes please sketch and show depths.

GROUND LEVEL

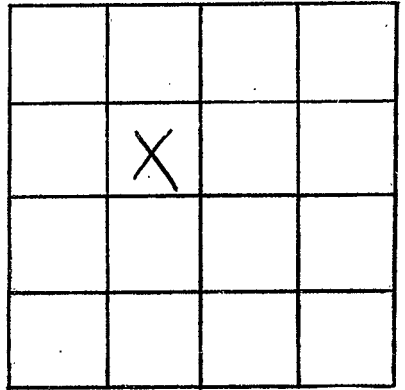

SECTION 7

Please indicate well location X.

ADDITIONAL INFORMATION

If more than one screen,
show locations of each on sketch.