

Winston
G 2000
4-16-76

MISSISSIPPI
 BOARD OF WATER COMMISSIONERS
 416 North State Street
 Jackson, Mississippi 39201

WATER WELL DRILLERS LOG

4-16 19 *76* *J. H. Harwood* *Winston*
 date well completed firm name county well located

LANDOWNER: *Arthur Kincaid*
Louisville Miss
 (mailing address)
 WELL LOCATION:
 sec. *7* T *15* N S R *14* E W
10 miles *East* of *Louisville*
 (distance) (direction) (nearest town)

WELL PURPOSE: *Home*
 (home, irrigation, municipal, industrial)

- WELL COMPLETION DATA:
- diameter (inches) *2"*
 - total depth (feet) *25*
 - static water level (feet) *17* below top of ground.
 - casing *PVC* (*20*)
 (material) (depth)
2" if telescope see back.
 (size)
 - screen *5'* (*25 - 20*)
 (length) (depth to top)
2" P.C. 8 plate Plastic
 (size) (material)
 - pump *1* (*4*)
 (HP) (yield gpm)
Electric
 (type power)
 - electric log *no*
 (yes or no)
- (organization running log)
- (8) how well bottom plugged _____


description of formations encountered	from	to
<i>pipe clay</i>	<i>0</i>	<i>18</i>
<i>of yellow sand</i>	<i>18</i>	<i>25</i>

DRILLERS REMARKS:

RECEIVED
MAY 26 1976
 MISS. DE. OF WATER CONTROL

If well telescopes please sketch and show depths.

GROUND LEVEL

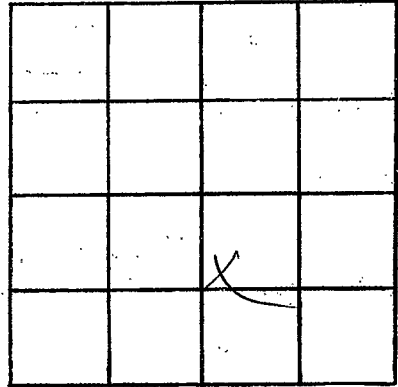

SECTION 7

Please indicate well location X.

ADDITIONAL INFORMATION

If more than one screen, show locations of each on sketch.