

WINSTON

G 2001

11-11-77

MISSISSIPPI
 BOARD OF WATER COMMISSIONERS
 416 North State Street
 Jackson, Mississippi 39201

136

WATER WELL DRILLERS LOG

11-11 date well completed 1977 firm name *J McDonald* Winston county well located

LANDOWNER: *Arthur Kincaid*
 ARTHUR KINCAID
Louisville Miss

description of formations encountered	from	to
<i>red clay</i>	0	18
<i>pipe + sand</i>	18	140
<i>gray clay + sand</i>	140	63
<i>sand</i>	63	68

(mailing address)

WELL LOCATION:
 sec. 7 T. 15 N. R. 14 E.
9 miles 2 of *Louisville*
 (distance) (direction) (nearest town)

WELL PURPOSE: *Home*
 (home, irrigation, municipal, industrial)

- WELL COMPLETION DATA:
- (1) diameter (inches) 2
 - (2) total depth (feet) 68
 - (3) static water level (feet) 40 below above top of ground.
 - (4) casing steel, 63
 (material) (depth)
2 if telescope see back.
 (size)
 - (5) screen 5', 68-63
 (length) (depth to top)
1/4 inch, 55
 (size) (material)
 - (6) pump 1/2, 5
 (HP) (yield gpm)
electric
 (type power)
 - (7) electric log no
 (yes or no)
- (organization running log)
- (8) how well bottom plugged _____


DRILLERS REMARKS:

RECEIVED
 NOV 18 1977

MISS. BD. OF WATER COMMISSIONERS

If well telescopes please sketch and show depths.

GROUND LEVEL

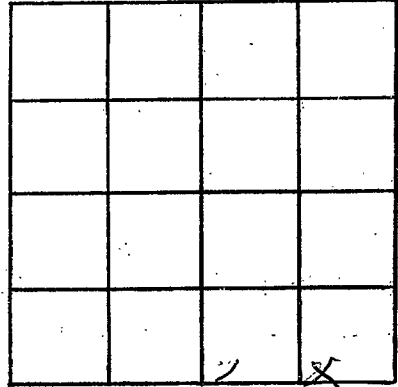

SECTION 7

Please indicate well location, X.

ADDITIONAL INFORMATION

If more than one screen, show locations of each on sketch.