

MISSISSIPPI DEPARTMENT OF NATURAL RESOURCES

Bureau of Land and Water Resources

Southport Mall

P.O. Box 10631

Jackson, Mississippi 39209

WATER WELL DRILLERS LOG

Winston
G 2002

December 2 19 87 Allsup Drilling, Inc. Winston
date well completed firm name county well located

LANDOWNER: Shirley Young
R. A. White
RR 4, Box 197
Louisville, MS 39339
(mailing address)


description of formations encountered	from	to
Clay	0	20
Sand	20'	55'
Hard Rock	55'	70'
Water Sand	70'	90'

WELL LOCATION:
sec. 35 T 15 N N R 14 E
XS W
12 miles E. of Louisville
(distance) (direction) (nearest town)

WELL PURPOSE: Home
(home, irrigation, municipal, industrial)

WELL COMPLETION DATA:

- (1) diameter (inches) 4" x 2"
- (2) total depth (feet) 90'
- (3) static water level (feet) 35' below above top of ground.
- (4) casing PVC Cased from Top-Bottom
(material) (depth)
4" if telescope see back.
(size)
- (5) screen 20' 70'
(length) (depth to top)
2" PVC
(size) (material)
- (6) pump 1 1/2 (Jet) 6e
(HP) (yield gpm)
Electric
(type power)
- (7) electric log No
(yes or no)
(organization running log)
- (8) how well bottom plugged Capped

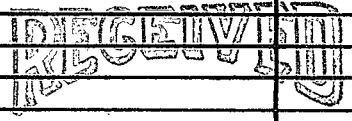

MAY 02 1988


Department of Natural Resources
Bureau of Land and Water Resources

DRILLERS REMARKS:

If well telescopes please sketch and show depths.

GROUND LEVEL

70' 4" CASING

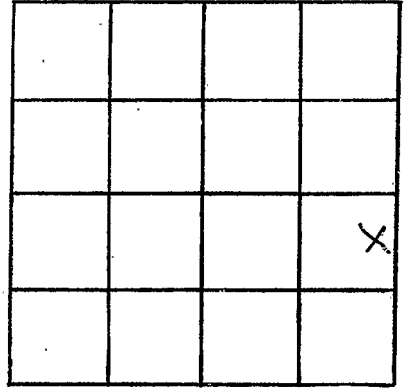

SW 1/4 of SECTION 35

Please indicate well location X.

ADDITIONAL INFORMATION

20' 4" SCREEN

If more than one screen, show locations of each on sketch.