

MISSISSIPPI DEPARTMENT OF NATURAL RESOURCES

Bureau of Land and Water Resources

Southport Mall

P.O. Box 10631

Jackson, Mississippi 39209

WATER WELL DRILLERS LOG

WINSTON  
G 2003

12/21/87  
date well completed

Allsup Drilling, Inc.  
firm name

WINSTON  
county well located

LANDOWNER: Shirley Young  
R.A. White  
RR 4, Box 197  
Louisville, MS 39339  
(mailing address)

description of formations encountered

from

to

Clay	0	20'
Sand	20'	55'
Hard Rock	55'	58'
Water Sand	58'	70'

WELL LOCATION:

sec. 35 T 15 N R 14 E  
12 miles E. of Louisville  
(distance) (direction) (nearest town)

WELL PURPOSE: Home  
(home, irrigation, municipal, industrial)

WELL COMPLETION DATA:

- (1) diameter (inches) 4"
- (2) total depth (feet) 70'
- (3) static water level (feet) 35' below above top of ground. Cased from
- (4) casing PVC top-bottom  
(material) (depth)  
4"  
(size) if telescope see back
- (5) screen 20' 50'  
(length) (depth to top)  
4" P.V.C.  
(size) (material)
- (6) pump 1/2 HP Jet 6  
(HP) (yield gpm)  
Electric  
(type power)
- (7) electric log \_\_\_\_\_  
(yes or no)  
\_\_\_\_\_  
(organization running log)
- (8) how well bottom plugged Capped

RECEIVED

MAY 02 1988


Department of Natural Resources  
Bureau of Land & Water Resources

DRILLERS REMARKS:

If well telescopes please sketch and show depths.

GROUND LEVEL

50' 4" casing

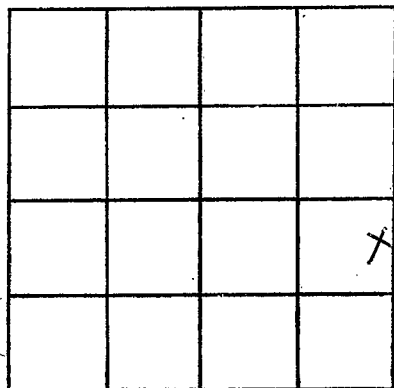

SW 1/4

SECTION 35

Please indicate well location X.

ADDITIONAL INFORMATION

Multiple horizontal lines for additional information.

20' 4" Screen

If more than one screen, show locations of each on sketch.