

CODED

WINSTON  
H B  
11-67

MISSISSIPPI  
BOARD OF WATER COMMISSIONERS  
416 North State Street  
Jackson, Mississippi 39201

WATER WELL DRILLERS LOG

11-16 1967 date well completed  
J. A. Smith firm name  
Winston county well located

LANDOWNER:

Emmette Whitenis

description of formations encountered

from to

(mailing address)

Clay 0' 20'  
Sand 30' 109'

WELL LOCATION:

sec. 1 T. 14(N) S. R. 100 E. W. 10 miles W of Jourd'heville (distance) (direction) (nearest town)

WELL PURPOSE: Home (home, irrigation, municipal, industrial)

WELL COMPLETION DATA:

(1) diameter (inches) 2 1/2  
(2) total depth (feet) 109'  
(3) static water level (feet) 80' below top of ground.

(4) casing 2 1/2" (material) 109' (depth)

~~if telescope see back.~~ (size)

(5) screen 2 1/2" (length) 109' (depth to top)

1/4" (size) (material)

(6) pump 3/4 HP (HP) 5 (yield gpm)

Electric (type power)

(7) electric log (yes or no)

(organization running log)

(8) how well bottom plugged


DRILLERS REMARKS:

MAY 10 1968

MISS. BD. OF  
WATER COMM.

If well telescopes please sketch and show depths.

GROUND LEVEL

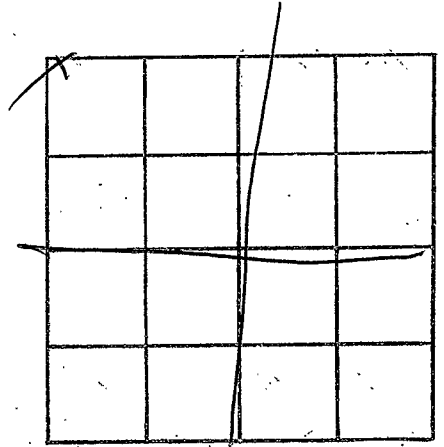

SECTION 1

Please indicate well location X.

ADDITIONAL INFORMATION

If more than one screen,  
show locations of each on sketch.